


Section 9 Township 9 Range 18W

Well No. 1 C. Holl

Company Isern Bros.

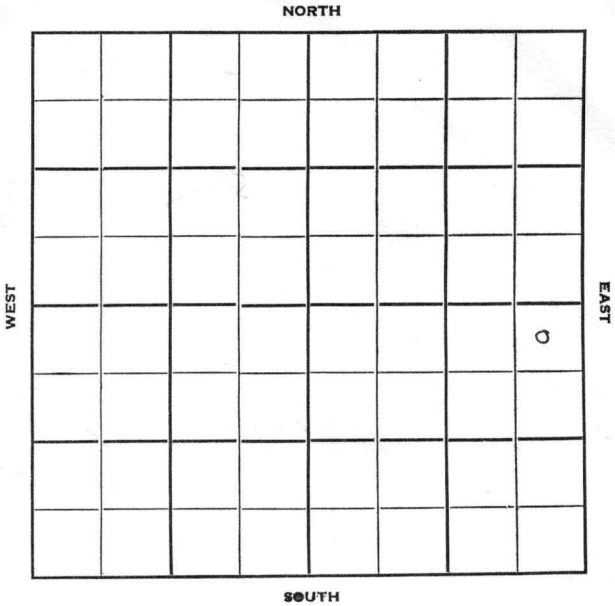

Rooks

KANSAS

Sec. 9 Twp. 9 R. 18 W

Well No. # 1 C. Holl Farm

Isern Bros. Company

Todd Drlg. Contractor


Wildcat

330 Ft. from N. Line

Ft. from S. Line

330 Ft. from E. Line

Ft. from W. Line

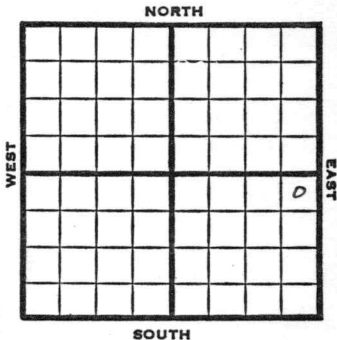

NE NE SE

Stanolind & Contl. DHM

1951

Elm - 2033 REPORT *271*

7/18

Spud 7-8-51

D & A TD 3633'

8" @ 180' Anhy 1435' Heeb 3211'

Lans. 3250' Cong 3506' Arb 3619'

TD 3633'

D & A

FIRST REPORT
ABANDONED

$$\begin{array}{r}
 3250 \\
 2033 \\
 \hline
 1217
 \end{array}$$

$$\begin{array}{r}
 3619 \\
 2033 \\
 \hline
 1586
 \end{array}$$

$$\begin{array}{r}
 3506 \\
 2033 \\
 \hline
 1473
 \end{array}$$

County **Rooks** State **Kansas**

Sec. **9** (Blk. Twp.) **9** (Sur. Rge.) **18W** Map No.

Operator **Isern Bros.**

Well No. **1** Farm **C. Holl**

Elev. Location **NE NE SE**

FIRST REPORT

ABANDONED

0

330 Ft. From **N** Line **SE**

330 Ft. From **E** Line **Quarter**

1st. Report **JUL 1 8 1951**

Completion **JUL 1 8 1951**

Remarks **Stano. & Cont'l DHM**

Todd D. lg. - Contr.

Spudding Date **7-8-51**

Drlg. Data **D & A** **TD 3633** **Wildcat**

8" @ 180 **Anhy 1435** **Heeb. 3211**

Lans. 3250 **Cong. 3506** **Arb. 3619**

TD 3633 **D & A**

J. E. TYRA