


Rooks county

Section 9 Township 9 Range 19-W

Well No. #2, McCellan

Company Phil-Han

*14*

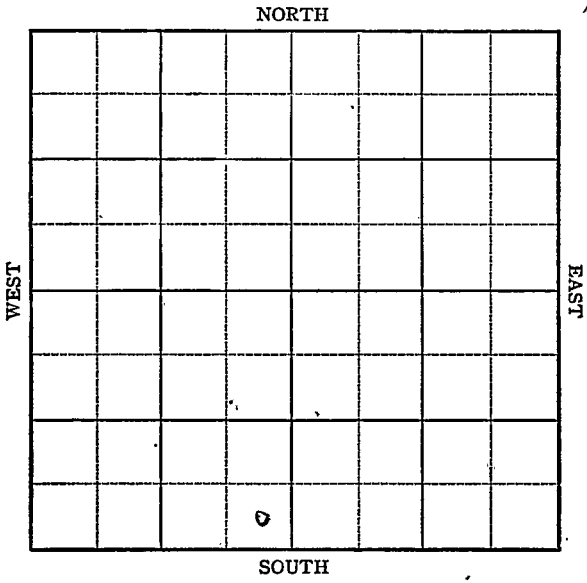

Sec. 9 Twp. 9 R. 19W

Well No. #2 McCellan Farm

Phil-Han Company


McCellan Pool

Ft. from N. Line

330 Ft. from S. Line

330 Ft. from E. Line

Ft. from W. Line

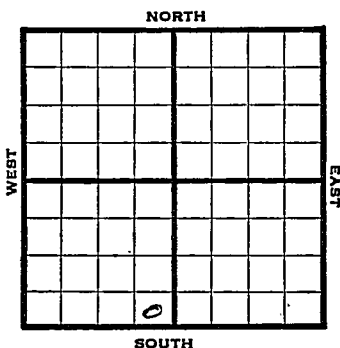

SE SW

1946

Elev. 2088' REPORT

10/23 Location

10/29 8" @ 1268' WOC

11/6 Lans 3291'

Drlg 3380'

11/13 Lans 3291'

Arb 3567'

TD 3620'

ABANDONED

KANSAS

Map No. 65 Sec. 9 Twp. 9 R. 19W

Well No. 2 McCellan

Phil-Han Company

FIRST REPORT

Contractor

SE SW

SECTION PLAT


Ft. from N. Line

330 Ft. from S. Line

330 Ft. from E. Line

Ft. from W. Line

Rooks County

Location X

Rig up

Drilling and Remarks:

RECORD

Cased \_\_\_\_\_ in., \_\_\_\_\_ ft.

Sand \_\_\_\_\_

Gas \_\_\_\_\_

Oil \_\_\_\_\_

Total Depth \_\_\_\_\_

PRODUCTION

1st 24 hrs. Nat. \_\_\_\_\_

1st 24 hrs: after shot \_\_\_\_\_

Gas \_\_\_\_\_ Cu. Ft.

Dry Hole \_\_\_\_\_

Abandoned \_\_\_\_\_

Date

OCT 23 1946 19

S. J. LEWIS

Scout

Map No. 45 Sec. 9 Twp. 9 R. 19W

Well No. 2 McCellan

Phil-Han Company

**ABANDONED**

Contractor

SE SW

*E. 2088*

**SECTION PLAT**

\_\_\_\_\_ Ft. from N. Line  
330 Ft. from S. Line  
330 Ft. from E. Line  
\_\_\_\_\_ Ft. from W. Line


Rooks County

Location \_\_\_\_\_

Rig up \_\_\_\_\_

Drilling and Remarks:

*Lease 3281*  
*CR 3562*

**RECORD**

Cased \_\_\_\_\_ in., \_\_\_\_\_ ft.  
Sand \_\_\_\_\_  
Gas \_\_\_\_\_  
Oil \_\_\_\_\_  
Total Depth 3620

**PRODUCTION**

1st 24 hrs. Nat. \_\_\_\_\_  
1st 24 hrs. after shot \_\_\_\_\_  
Gas \_\_\_\_\_ Cu. Ft.  
Dry Hole \_\_\_\_\_  
Abandoned \_\_\_\_\_

Date

NOV 13 1946 19

**S. J. LEWIS** Scout