

Graham

KANSAS

9

9

21W

SECTION _____ TOWNSHIP _____ RANGE _____


#3 Clack

WELL NO. _____

Barnett

COMPANY _____

NORTH

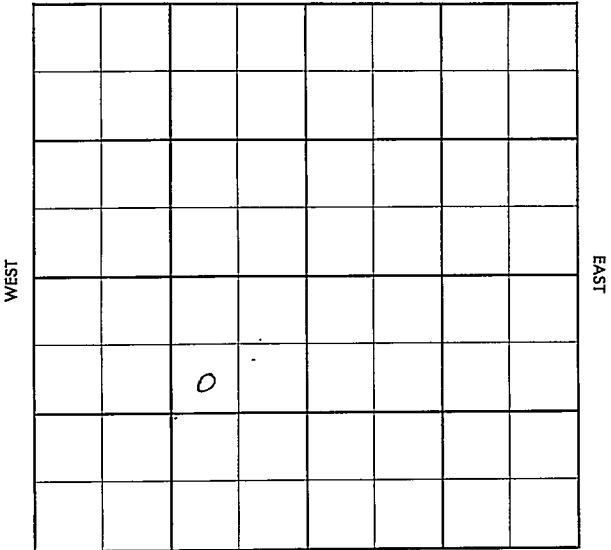

SOUTH

County Graham Elev. _____
Sec. 9 Twp. 19 Rge. 21W
Company Barnett
Farm Name Clack No. 3

TOPS	DEPTH	LOG	DATUM
Anb.			
TP.			
H.			
Tr.			
Dg.			
Bl.			
L.			
K.C.			
B.K.C.			
Ce.			
C.			
M.			
M.			
K.			
Mz.			
Mo.			
V.			
S.			
S.			
A.			
R.			
PE.			
G.			
T.D.			

Loc. in Sec. SW NE SW
Geol. _____
Contr. _____
Co. Tools _____
Pool Morel

SEP 26 '56
FIRST REPORT
0

Date Comm. _____
Location _____

Co.
Lse.
No.
Sec.
T.
R.

County Graham Elev. 2185
 Sec. 9 Twp. 9 Rge. 21W
 Company Barnett
 Farm Name Clack No. 3

TOPS	DEPTH	LOG	DATUM	Loc. in Sec.
Anb.				SW NE SW
Tr.				
H.	3350			
Tr.				
Dg.				
BL.				
L.	3389			Geol.
K.C.				Contr.
BKG.	3601			Co. Tools
Ce.				
C.				Pool
M.				Morel
M.				
K.				
Mz.				
Ma.				
V.				
S.				
S.				
A.	3698			
R.				
PE.				
G.				
TD.	3700			

ABANDONED

OCT 24 '56

Date Comm.

Location OCT 3 '56 9 - 26 - 56

8⁵/₈ 145 1125 113400UCI 10 '56 5¹/₂ @ 3698/1125 RUCT OCT 17 '56

Co DD 3704 1/2 +st 1/4 Boph

no1w DD 3709 1/2 no 17c

DD 3712 1/2 \$ 1/4 Boph + Ac.

wt DD 3716 3/4 +st 1/4 Boph

OCT 24 '56 +st 40 G + 10.6W DD

3718 FU 200 Fluid DD 3740

Hole Fu 11 wta

D.E.A