

SECTION 9 TOWNSHIP _____ RANGE 9S 22W

WELL NO. #1 Rice Estate

COMPANY Gulf Oil Corp.

NORTH ~~#~~ NW SE SE

						0	

WEST

EAST

SOUTH

Graham

KANSAS

SEC.	9	TWP.	9 S	R.	22 W
------	---	------	-----	----	------

WELL NO.

1 Rice Estate

FARM

COMPANY

Gulf Oil Corp.

CONTRACTOR

Wildcat


_____ FT. FROM N. LINE

_____ FT. FROM S. LINE

_____ FT. FROM E. LINE

_____ FT. FROM W. LINE

NW SE SE

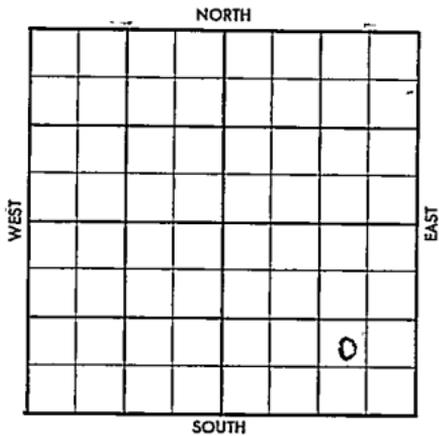

SDX-1/4 Mile

	ELEVATION	REPORT
1957		3950' Arb. Test
8/14	Location	(FR Tkt)

Van

FORM 513 SUNRAY

2294 DF

County Graham

Elev. 2299 KB

Sec. 9

Twp. 9

Rge. 22W

Company Gulf Oil Corp.

Farm Name Rice Estate

No. 1

TOPS	DEPTH	LOG	DATUM	Loc. in Sec.
Anh.	1845			NW SE SE
TP.				
H.	3512	3512		3950' Arb test
Tr.	3537			
Dg.				
Bl.				
L.	3552	3552		Geol.
K.C.				Contr. <u>K & E</u>
B.K.C.				
Ce.				
C.				
M.				Pool <u>Wildhorse</u>
M.				<u>Wildcat</u>
K.				
Mz.				
Mo.				
V.				
S.				
S.				
A.		3900		
R.				
PE.				
G.				
TR.	3909			

100 30 57
 1/4 mile
 ABANDONED

Date Comm.

Location AUG 21 57 AUG 28 57 P-21-57

P 5/8 c. 409/250 @ 3523

SEP 4 57 DST 3901-04 30" 10' M

All presso DST 3904-09 1hr.

75' clean oil + 50' WM FP

30-60 BHP 740 120" 5 1/2

3901/125 WOC. SEP 11 57 CO ~~3309~~ 3909

\$ 40 gal MCO \$ 109.0

pk for 6 hrs 500 A \$ 33 B0

\$.69 WT

DD 3911 1/2 \$ 7.7 BO 3 hrs

no W DD 3915 CO \$ 8.32

BO in 3 hrs \$ 12 BO no W

in 6 Hrs DD 3919 \$ 29 BO

no W 15 hrs A red hd 69

BO no W 17 hrs ~~23~~ Ar 23°

SEP 18 '57 Proc 5x5 \$ LD

SEP 25 '57 OCT 2 '57 OCT 9 '57 OCT 16 '57

OCT 23 '57 OCT 30 '57 Lost LD

P-6A

9-9-22 W

no W series