


Graham

KANSAS

SECTION 9 TOWNSHIP 9 RANGE 23W

WELL NO. #2 Beiker

COMPANY Imperial Oil Co.

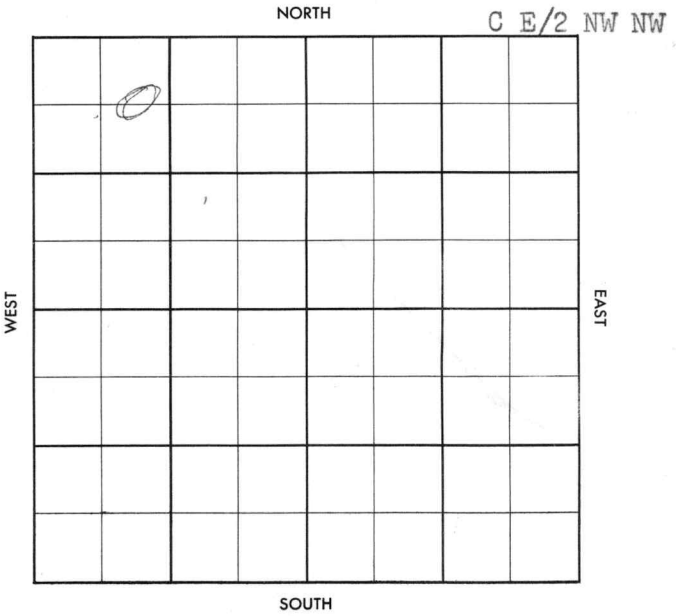

County Graham

Elev. _____

Sec. 9Twp. 9Rge. 23WCompany Imperial Oil Co.Farm Name BeikerNo. 2

TOPS	DEPTH	LOG	DATUM
Anb.			
Tr.			
H.			
Tr.			
Dg.			
Bl.			
L.			
K.C.			
B.K.C.			
Ce.			
C.			
M.			
M.			
K.			
Mz.			
Mq.			
V.			
S.			
S.			
A			
R.			
Pt.			
G.			
T.D.			

Loc. in Sec. _____

C E/2 NW NW

Geol. _____

Contr. _____

Pool

Brush Creek

JUN 12 1957

FIRST REPORT

Date Comm. 6-9-57

8" @ 220/175, Drlg. 340

5

County Graham Elev. 2330
 Sec. 9 Twp. 9 Rge. 23W
 Company Imperial Oil Co.
 Farm Name Beiker No. 2

TOPS	DEPTH	LOG	DATUM	Loc. in Sec.
Anh.	1972			C E/2 NW NW
TP.				
H.	2628			
Tr.	3651			
Dg.				
BL.				
L.	3667			Geol.
K.C.				Contr.
B.K.C.				
Ce.				
C.				
M.				Pool
M.				Brush Creek
K.				
Mz.				
Mq.				
V.				
S.				
S.				
A.				
R.				
PE.				
G.				
TD.	3890			

	JUN 26 57	

ABANDONED

Date Comm. 6-9-57

8" @ 220/175, Dr. 340 JUN 12 57 DST

3729-28 120" rec 145' SW

BHP 1230 DST 3791-99

1hr rec 55' Md BHP 200

DST 3812-25 120" rec 55'

Md BHP 1400 D 3840 JUN 26 57

DST 3845-55 1hr rec 5' Md

BHP 170

D.E.A.