

Graham

KANSAS

9


9S

23W

SECTION _____ TOWNSHIP _____ RANGE _____

WELL NO. #1 Radcliffe

COMPANY Champlin O&R

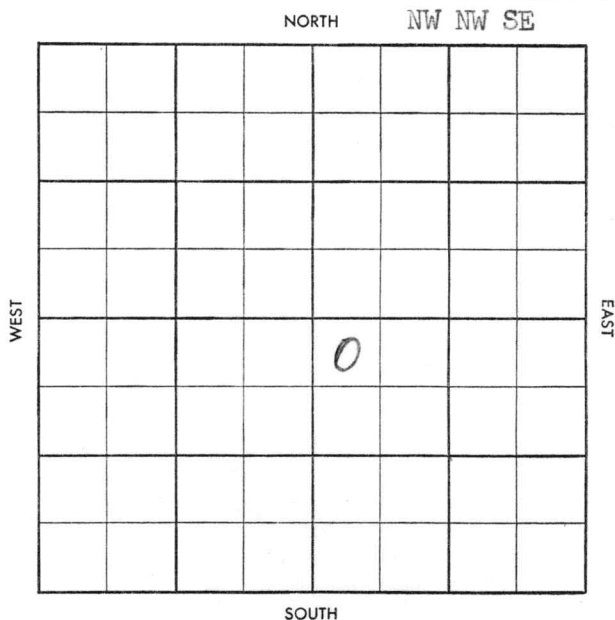

CO. Graham ELEV. _____SEC. 9 TWP. 9 RGE. 23WCOMPANY Champlin O & R NO. 1

FIRST REPORT

NOV 13 1977

FARM RadcliffeLOC. NW NW SE

GEOL. _____

CONTR. _____

POOL Brush Creek

SPUD _____

Location _____

CO.

LSE.

NO.

SEC.

TWP.

RGE.

CO. Graham ELEV. 23660SEC. 9 TWP. 9 RGE. 23WCOMPANY. Champlin O & R NO. 1

COMPLETE

JAN 2 '58

FARM RadcliffeLOC. NW NW SE

GEOL.

CONTR. ArnerPOOL Brush CreekSPUD 11-20-57Location NOV 20 '57MVRT NOV 27 '57

8" 251/200

Ø 3060 DEC 4 '57

Lsg 3682 DST

3709-33 120"

TD 3905

g 150" run 3305' 0 NW
 F-P 370 - 1108 BHP 1345/60"
 DST 3745-57 120" 155'
 H 019 cm BHP 940/60"
 DST 3806-22 120" 105'
 H 06 g cm 67' 0 F-P 35-80
 BHP 430/60" DST 3829-40
 120" 15' m all P O DST
 3839-57 120" 10' m BHP
 35/20" DST 3858-76.

120" 120' gap 187'
 H 0 6 g cm BHP 350/60"
 TD 3905 Log tops Hb
 3646 TR 3669 Lsg 3683
 PKC 3902 run 52' DEC 17 '57
 3903/200 CO 3878 12/3869
 -73 H 292 NW NT $\frac{1}{2}$ \$
 134 BOPH NW 2 hrs $\frac{1}{3}$
 \$ 7 BOPH NW 5 hrs POP
DEC 18 '57 P 90 BO NW 21 hrs
DEC 26 '57 P 78 BO NW 24 hrs
JAN 2 '58 Pot p 74 BOPD NW
 24 hrs SW 320

Lsg 3569-73