

For KCC Use:
Effective Date: 8-31-03
District #: 3
SGA? Yes No

KANSAS CORPORATION COMMISSION
OIL & GAS CONSERVATION DIVISION
NOTICE OF INTENT TO DRILL

^{First}
CORRECTED

Form C-1
September 1999
Form must be Typed
Form must be Signed
All blanks must be Filled

Must be approved by KCC five (5) days prior to commencing well

Expected Spud Date: August 20, 2003
month day year

OPERATOR: License# 33264
Name: Central Production Co. Inc.
Address: 718 Oak St.
City/State/Zip: Humboldt, KS 66748
Contact Person: John Sperry
Phone: 417-667-5062/417-684-4234

CONTRACTOR: License# 33274
Name: David Casey

Spot: East West
SE 1/4 NW 4 NE 4 Sec. 10 Twp. 35 S. R. 21
4070 feet from (S) / N (circle one) Line of Section
1631 feet from (E) / W (circle one) Line of Section
Is SECTION Regular Irregular?

(Note: Locate well on the Section Plat on reverse side)

County: Labette
Lease Name: Barr Well #: B30

Field Name: Chetopa

Is this a Prorated / Spaced Field? Yes No

Target Formation(s): Bartlesville

Nearest Lease or unit boundary: 1009'

Ground Surface Elevation: 826.58 feet MSL

Water well within one-quarter mile: Yes No

Public water supply well within one mile: Yes No

Depth to bottom of fresh water: 200 ft+

Depth to bottom of usable water: 300 ft+

Surface Pipe by Alternate: 1 X 2

Length of Surface Pipe Planned to be set: 20 ft

Length of Conductor Pipe required: 20 ft

Projected Total Depth: 150'

Formation at Total Depth: Bartlesville

Water Source for Drilling Operations:
Well Farm Pond Other none - air rotary

DWR Permit #: _____

(Note: Apply for Permit with DWR)

Will Cores be taken? Yes No

If Yes, proposed zone: _____

Well Drilled For: Oil Gas GWD Seismic Other
Well Class: Enh Rec Storage Disposal Other
Type Equipment: Air Rotary Mud Rotary Cable
Pool Ext. Widcut

If GWD: old well information as follows:
Operator: _____
Well Name: _____
Original Completion Date: _____ Original Total Depth: _____

Directional: Deviated or Horizontal wellbore? Yes No

If Yes, true vertical depth: _____

Bottom Hole Location: _____

KCC DKT #: _____

* Was: EOR Is: Oil

AFFIDAVIT

The undersigned hereby affirms that the drilling, completion and eventual plugging of this well will comply with K.S.A. 55-101, et. seq. It is agreed that the following minimum requirements will be met:

1. Notify the appropriate district office *prior* to spudding of well;
2. A copy of the approved notice of intent to drill *shall be posted* on each drilling rig;
3. The minimum amount of surface pipe as specified below *shall be set* by circulating cement to the top; in all cases surface pipe shall be set through all unconsolidated materials plus a minimum of 20 feet into the underlying formation;
4. If the well is dry hole, an agreement between the operator and the district office on plug length and placement is necessary;
5. The appropriate district office will be notified before well is either plugged or production casing is cemented in;
6. If an ALTERNATE TO COMPLETION, production pipe shall be cemented from below any usable water to surface within 120 days of spud date. *In all cases, NOTIFY district office prior to any cementing.*

I hereby certify that the statements made herein are true and to the best of my knowledge and belief.

Date: 8/13/03 Signature of Operator or Agent: John Sperry Title: Vice-president--Eng

For KCC Use ONLY

AP # 15 - 099-23330-00-00

Conductor pipe required: NONE feet

Minimum surface pipe required: 20' feet per Akt. 2

Approved by: DPW 8-26-03 RSP 2-2-04

This authorization expires: 2-26-04 8-26-04

(This authorization void if drilling not started within 5 months of effective date.)

Spud date: _____ Agent: _____

Remember to:

- File Drill Pit Application (form CDP-1) with Intent to Drill;
- File Completion Form ACO-1 within 120 days of spud date;
- File acreage attribution plat according to field protraction orders;
- Notify appropriate district office 48 hours prior to workover or re-entry;
- Submit plugging report (CP-4) after plugging is completed;
- Obtain written approval before disposing or injecting salt water.

Mail to: KCC - Conservation Division, 130 S. Market - Room 2078, Wichita, Kansas 67202

Permit Extension Request Received 1-25-04

RECEIVED
KANSAS CORPORATION COMMISSION

AUG 18 2003

CONSERVATION DIVISION
WICHITA, KS

10
35
216

IN ALL CASES PLOT THE INTENDED WELL ON THE PLAT BELOW

Plat of acreage attributable to a well in a prorated or spaced field

If the intended well is in a prorated or spaced field, please fully complete this side of the form. If the intended well is in a prorated or spaced field complete the plat below showing that the well will be properly located in relationship to other wells producing from the common source of supply. Please show all the wells and within 1 mile of the boundaries of the proposed acreage attribution unit for gas wells and within 1/2 mile of the boundaries of the proposed acreage attribution unit for oil wells.

API No. 15 - _____
 Operator: Central Production Co., Inc.
 Lease: Parr
 Well Number: B30
 Field: Chetopa
 Number of Acres attributable to well: 0.50
 QTR / QTR / QTR of acreage: SE 1/4 - NW 1/4 - NE 1/4



4070 feet from N / S Line of Section
1631 feet from E / W Line of Section
 Sec. 10 Twp. 35 S. R. 21 East West

is Section X Regular or _____ Irregular

If Section is Irregular, locate well from nearest corner boundary.
 Section corner used: ___NE ___NW ___SE ___SW

PLAT

*(Show location of the well and shade attributable acreage for prorated or spaced wells.)
 (Show footage to the nearest lease or unit boundary line.)*

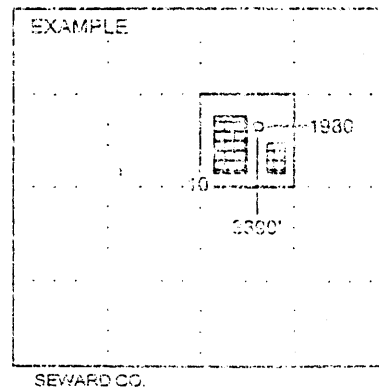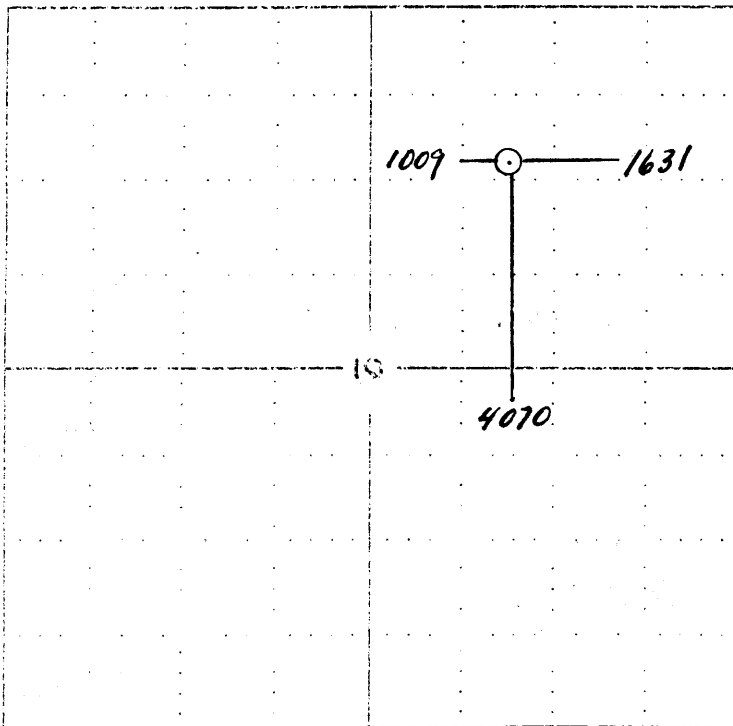

NOTE: In all cases locate the spot of the proposed drilling location.

In plotting the proposed location of the well, you must show:

1. The manner in which you are using the depicted plat by identifying section lines, i.e. 1 section, 1 section with 8 surrounding sections, 4 sections, etc.
2. The distance of the proposed drilling location from the section's south / north and east / west.
3. The distance to the nearest lease or unit boundary line.
4. If proposed location is located within a prorated or spaced field a certificate of acreage attribution plat must be attached: (CO-7 for oil wells; CO-8 for gas wells).