

For KCC Use:
 Effective Date: _____
 District #: _____
 SGA? Yes No

KANSAS CORPORATION COMMISSION
 OIL & GAS CONSERVATION DIVISION

RECEIVED

Form C-1
 December 2002

NOTICE OF INTENT TO DRILL

SEP 16 2003

Form must be Typed
 Form must be Signed
 All blanks must be Filled

Must be approved by KCC five (5) days prior to commencing well

Expected Spud Date September 1, 2003
month day year **N/2**

OPERATOR: License# 33264
 Name: Central Production Co. Inc
 Address: 718 Oak St.
 City/State/Zip: Humboldt, KS 66748
 Contact Person: John Sperry
 Phone: 417-667-5062/417-684-4294

CONTRACTOR: License# 33274
 Name: David Casey

CONSERVATION DIVISION
 WICHITA, KS

Spot NW/4 SW/4 NE/4 Sec. 10 Twp. 35 S. R. 21E East West
3932 feet from N / S Line of Section
2024.5 feet from E / W Line of Section
 Is SECTION Regular Irregular?

(Note: Locate well on the Section Plat on reverse side)

County: Lafayette
 Lease Name: Barr Well #: N6L
 Field Name: Chetopa

Is this a Prorated / Spaced Field? Yes No
 Target Information(s): Bartlesville

Nearest Lease or unit boundary: 615.5
 Ground Surface Elevation: 830.98 feet MSL

Water well within one-quarter mile: Yes No
 Public water supply well within one mile: Yes No

Depth to bottom of fresh water: 200+ ft
 Depth to bottom of usable water: 300+ ft

Surface Pipe by Alternate: 1 2
 Length of Surface Pipe Planned to be set: 20 ft

Length of Conductor Pipe required: 20 ft
 Projected Total Depth: 150'

Formation at Total Depth: Bartlesville
 Water Source for Drilling Operations:

Well Farm Pond Other none - air rotary
 DWR Permit #: _____

(Note: Apply for Permit with DWR)

Will Cores be taken? Yes No
 If Yes, proposed zone: _____

AFFIDAVIT

The undersigned hereby affirms that the drilling, completion and eventual plugging of this well will comply with K.S.A. 55 et. seq.

It is agreed that the following minimum requirements will be met:

1. Notify the appropriate district office **prior** to spudding of well;
2. A copy of the approved notice of intent to drill **shall be** posted on each drilling rig;
3. The minimum amount of surface pipe as specified below **shall be set** by circulating cement to the top; in all cases surface pipe **shall be set** through all unconsolidated materials plus a minimum of 20 feet into the underlying formation.
4. If the well is dry hole, an agreement between the operator and the district office on plug length and placement is necessary **prior to plugging**;
5. The appropriate district office will be notified before well is either plugged or production casing is cemented in;
6. If an ALTERNATE II COMPLETION, production pipe shall be cemented from below any usable water to surface within **120 days** of spud date.
 Or pursuant to Appendix "B" - Eastern Kansas surface casing order #133,891-C, which applies to the KCC District 3 area, alternate II cementing must be completed within 30 days of the spud date or the well shall be plugged. **In all cases, NOTIFY district office** prior to any cementing.

I hereby certify that the statements made herein are true and to the best of my knowledge and belief.

John S. Sperry

Date: August 19, 2003 Signature of Operator or Agent: _____ Title: V. P. - Engr

Permit Extension -
 Request Received 1-25-04

For KCC Use ONLY

API # 15 - 099-23355-0000

Conductor pipe required NONE feet

Minimum surface pipe required 20 feet per Alt. **(2)**

Approved by: RSP 9-16-03

This authorization expires: 9-3-16-04 / 9-16-04
 (This authorization void if drilling not started within 6 months of effective date.)

Spud date: _____ Agent: _____

Remember to:

- File Drill Pit Application (form CDP-1) with Intent to Drill;
 - File Completion Form ACO-1 within 120 days of spud date;
 - File acreage attribution plat according to field proration orders;
 - Notify appropriate district office 48 hours prior to workover or re-entry;
 - Submit plugging report (CP-4) after plugging is completed;
 - Obtain written approval before disposing or injecting salt water.
- If this permit has expired (See: authorized expiration date) please check the box below and return to the address below.

Well Not Drilled - Permit Expired

Signature of Operator or Agent: _____
 Date: _____

Mail to: KCC - Conservation Division, 130 S. Market - Room 2078, Wichita, Kansas 67202

10
35
2/E

IN ALL CASES PLOT THE INTENDED WELL ON THE PLAT BELOW

Plat of acreage attributable to a well in a prorated or spaced field

If the intended well is in a prorated or spaced field, please fully complete this side of the form. If the intended well is in a prorated or spaced field complete the plat below showing that the well will be properly located in relationship to other wells producing from the common source of supply. Please show all the wells and within 1 mile of the boundaries of the proposed acreage attribution unit for gas wells and within 1/2 mile of the boundaries of the proposed acreage attribution unit for oil wells.

API No. 15 - _____
 Operator: Central Production Co. Inc
 Lease: Barr
 Well Number: N6L
 Field: Chetopa
 Number of Acres attributable to well: 0.5
 QTR / QTR / QTR of acreage: NW/4 SW/4 NE/4



Location of Well: County: Labette
3932 feet from N / S Line of Section
2024.5 feet from E / W Line of Section
 Sec. 10 Twp. 35 S. R. 21E East West

Is Section: Regular or Irregular

If Section is Irregular, locate well from nearest corner boundary.
 Section corner used: NE NW SE SW

PLAT

*(Show location of the well and shade attributable acreage for prorated or spaced wells.)
 (Show footage to the nearest lease or unit boundary line.)*

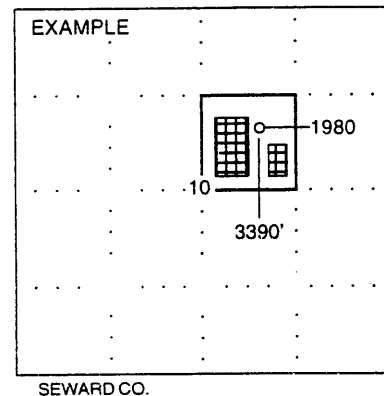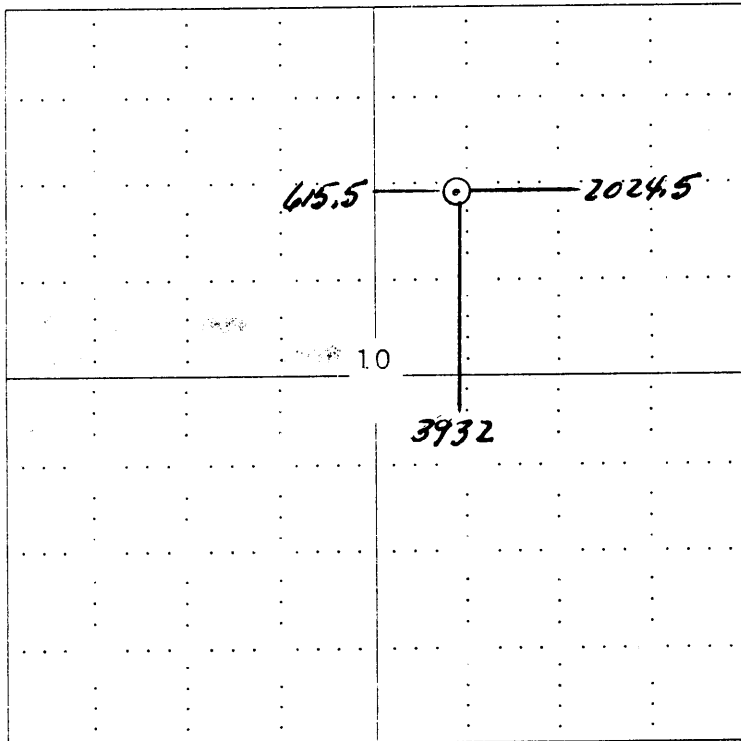

NOTE: In all cases locate the spot of the proposed drilling locaton.

In plotting the proposed location of the well, you must show:

1. The manner in which you are using the depicted plat by identifying section lines, i.e. 1 section, 1 section with 8 surrounding sections, 4 sections, etc.
2. The distance of the proposed drilling location from the section's south / north and east / west.
3. The distance to the nearest lease or unit boundary line.
4. If proposed location is located within a prorated or spaced field a certificate of acreage attribution plat must be attached: (CO-7 for oil wells; CG-8 for gas wells).