

For KCC Use: 9-21-03
Effective Date: 9-21-03
District #: 3
SGA? Yes No

KANSAS CORPORATION COMMISSION
OIL & GAS CONSERVATION DIVISION

RECEIVED
KANSAS CORPORATION COMMISSION
Form C-1
December 2002
Form must be Typed
Form must be Signed
All blanks must be Filled

NOTICE OF INTENT TO DRILL

SEP 16 2003

Must be approved by KCC five (5) days prior to commencing well

CONSERVATION DIVISION
WICHITA, KS

Expected Spud Date: September 1, 2003
month day year

Spot East West
NW/4 SW/4 NE/4 Sec. 10 Twp. 35 S. R. 21E

OPERATOR: License# 33254
Name: Central Production Co. Inc
Address: 718 Oak St.
City/State/Zip: Humboldt, KS 66748
Contact Person: John Sperry
Phone: 417-667-5062/417-684-4294

3932 feet from N / S Line of Section
2029.5 feet from E / W Line of Section
is SECTION Regular Irregular?

CONTRACTOR: License# 33274
Name: David Casey

(Note: Locate well on the Section Plat on reverse side)
County: Labette
Lease Name: Barr Well #: N6U

Field Name: Chetopa
Is this a Prorated / Spaced Field? Yes No

Target Information(s): Bartlesville
Nearest Lease or unit boundary: 610.5
Ground Surface Elevation: 830.98 feet MSL

Well Drilled For: Oil Enh Rec Infield
 Gas Storage Pool Ext.
 OWWO Disposal Wildcat
 Seismic; # of Holes Other
Well Class: Mud Rotary Air Rotary Cable
Type Equipment: Mud Rotary Air Rotary Cable

Water well within one-quarter mile: Yes No
Public water supply well within one mile: Yes No

Depth to bottom of fresh water: 200+ ft
Depth to bottom of usable water: 300+ ft

If OWWO: old well information as follows:
Operator: _____
Well Name: _____
Original Completion Date: _____ Original Total Depth: _____

Surface Pipe by Alternate: 1 2
Length of Surface Pipe Planned to be set: 20 ft

Length of Conductor Pipe required: 20 ft
Projected Total Depth: 150'

Directional, Deviated or Horizontal wellbore? Yes No

Formation at Total Depth: Bartlesville
Water Source for Drilling Operations:
 Well Farm Pond Other none - air rotary

If Yes, true vertical depth: _____

DWR Permit #: _____
(Note: Apply for Permit with DWR)

Bottom Hole Location: _____

Will Cores be taken? Yes No

KCC DKT #: _____

If Yes, proposed zone: _____

AFFIDAVIT

The undersigned hereby affirms that the drilling, completion and eventual plugging of this well will comply with K.S.A. 55 et. seq.

It is agreed that the following minimum requirements will be met:

1. Notify the appropriate district office **prior** to spudding of well;
2. A copy of the approved notice of intent to drill **shall be** posted on each drilling rig;
3. The minimum amount of surface pipe as specified below **shall be set** by circulating cement to the top; in all cases surface pipe **shall be set** through all unconsolidated materials plus a minimum of 20 feet into the underlying formation.
4. If the well is dry hole, an agreement between the operator and the district office on plug length and placement is necessary **prior to plugging**;
5. The appropriate district office will be notified before well is either plugged or production casing is cemented in;
6. If an ALTERNATE II COMPLETION, production pipe shall be cemented from below any usable water to surface within **120 days** of spud date. Or pursuant to Appendix "B" - Eastern Kansas surface casing order #133,891-C, which applies to the KCC District 3 area, alternate II cementing must be completed within 30 days of the spud date or the well shall be plugged. **In all cases, NOTIFY district office** prior to any cementing.

Permit Extension -
Request Received 1-25-04

I hereby certify that the statements made herein are true and to the best of my knowledge and belief.

Date: August 19, 2003 Signature of Operator or Agent: John S. Sperry Title: V.P. - Engr

For KCC Use ONLY
API # 15 - 099-23354.00-00
Conductor pipe required NONE feet
Minimum surface pipe required 20 feet per Alt. (2)
Approved by: RJP 9-16-03
This authorization expires: 3-16-04 / 9-16-04
(This authorization void if drilling not started within 6 months of effective date.)
Spud date: _____ Agent: _____

Remember to:
- File Drill Pit Application (form CDP-1) with Intent to Drill;
- File Completion Form ACO-1 within 120 days of spud date;
- File acreage attribution plat according to field proration orders;
- Notify appropriate district office 48 hours prior to workover or re-entry;
- Submit plugging report (CP-4) after plugging is completed;
- Obtain written approval before disposing or injecting salt water.
- If this permit has expired (See: authorized expiration date) please check the box below and return to the address below.
 Well Not Drilled - Permit Expired
Signature of Operator or Agent: _____
Date: _____

Mail to: KCC - Conservation Division, 130 S. Market - Room 2078, Wichita, Kansas 67202

10
55
2/E

IN ALL CASES PLOT THE INTENDED WELL ON THE PLAT BELOW

Plat of acreage attributable to a well in a prorated or spaced field

If the intended well is in a prorated or spaced field, please fully complete this side of the form. If the intended well is in a prorated or spaced field complete the plat below showing that the well will be properly located in relationship to other wells producing from the common source of supply. Please show all the wells and within 1 mile of the boundaries of the proposed acreage attribution unit for gas wells and within 1/2 mile of the boundaries of the proposed acreage attribution unit for oil wells.

API No. 15 - _____
 Operator: Central Production Co. Inc
 Lease: Barr
 Well Number: N6U
 Field: Chetopa
 Number of Acres attributable to well: 0.5
 QTR / QTR / QTR of acreage: NW/4 - SW/4 - NE/4



Location of Well: County: Labette
3932 feet from N / S Line of Section
2029.5 feet from E / W Line of Section
 Sec. 10 Twp. 35 S. R. 21E East West

Is Section: Regular or Irregular

If Section is Irregular, locate well from nearest corner boundary.
 Section corner used: NE NW SE SW

PLAT

(Show location of the well and shade attributable acreage for prorated or spaced wells.)
 (Show footage to the nearest lease or unit boundary line.)

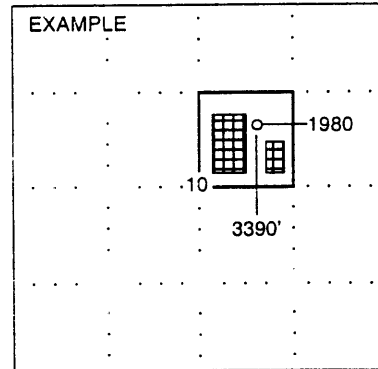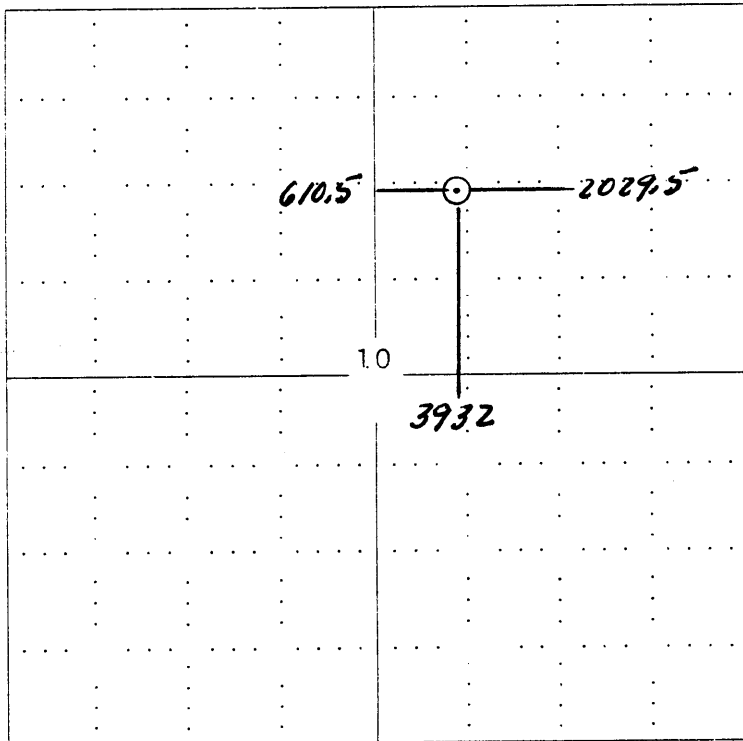

SEWARD CO.

NOTE: In all cases locate the spot of the proposed drilling location.

In plotting the proposed location of the well, you must show:

1. The manner in which you are using the depicted plat by identifying section lines, i.e. 1 section, 1 section with 8 surrounding sections, 4 sections, etc.
2. The distance of the proposed drilling location from the section's south / north and east / west.
3. The distance to the nearest lease or unit boundary line.
4. If proposed location is located within a prorated or spaced field a certificate of acreage attribution plat must be attached: (C0-7 for oil wells; CG-8 for gas wells).