

Permit Extension - Request Received 2-4-04

OWWO

RECEIVED

SEP 05 2003

KCC WICHITA

Form C-1 December 2002 Form must be Typed Form must be Signed All blanks must be Filled

For KCC Use: Effective Date: 9.14.03 District # 2 SGA? Yes No

KANSAS CORPORATION COMMISSION OIL & GAS CONSERVATION DIVISION NOTICE OF INTENT TO DRILL

Must be approved by KCC five (5) days prior to commencing well

Expected Spud Date September 15 2003 month day year

OPERATOR: License# 5030 Name: Vess Oil Corporation Address: 8100 E. 22nd St North, Bldg. 300 City/State/Zip: Wichita, KS 67226 Contact Person: W.R. Horigan Phone: 316-682-1537 X102

CONTRACTOR: License# 32991 Name: Simmons Well Service, Inc.

Spot W/2 SW NW Sec. 9 Twp. 25 S. R. 05 1890 feet from N / S Line of Section 400 feet from E / W Line of Section Is SECTION Regular Irregular?

(Note: Locate well on the Section Plat on reverse side)

County: Butler Lease Name: Wilson A Well #: 340 OWWO Field Name: El Dorado

Is this a Prorated / Spaced Field? Yes No Target Information(s): White Cloud

Nearest Lease or unit boundary: 1890 (unit boundary) Ground Surface Elevation: 1368' (estimate) feet MSL

Water well within one-quarter mile: Yes No Public water supply well within one mile: Yes No

Depth to bottom of fresh water: 160 Depth to bottom of usable water: 180

Surface Pipe by Alternate: 1 2 Length of Surface Pipe Planned to be set: 667

Length of Conductor Pipe required: none Projected Total Depth: 1050

Formation at Total Depth: White Cloud

Water Source for Drilling Operations: Well Farm Pond Other X

DWR Permit #: Will Cores be taken? Yes No

If Yes, proposed zone:

Well Drilled For: Oil Gas OWO Seismic; # of Holes Other Pulling unit, mud pump and power swivel Well Class: Infield Pool Ext. Wildcat Other Type Equipment: Mud Rotary Air Rotary Cable

If OWWO: old well information as follows: Operator: Cities Service Company Well Name: Wilson A #340 Original Completion Date: 12/2/59 Original Total Depth: 675

Directional, Deviated or Horizontal wellbore? Yes No

If Yes, true vertical depth: Bottom Hole Location: KCC DKT #:

AFFIDAVIT

The undersigned hereby affirms that the drilling, completion and eventual plugging of this well will comply with K.S.A. 55 et. seq. It is agreed that the following minimum requirements will be met:

- 1. Notify the appropriate district office prior to spudding of well;
2. A copy of the approved notice of intent to drill shall be posted on each drilling rig;
3. The minimum amount of surface pipe as specified below shall be set by circulating cement to the top; in all cases surface pipe shall be set through all unconsolidated materials plus a minimum of 20 feet into the underlying formation.
4. If the well is dry hole, an agreement between the operator and the district office on plug length and placement is necessary prior to plugging;
5. The appropriate district office will be notified before well is either plugged or production casing is cemented in;
6. If an ALTERNATE II COMPLETION, production pipe shall be cemented from below any usable water to surface within 120 days of spud date. Or pursuant to Appendix "B" - Eastern Kansas surface casing order #133,891-C, which applies to the KCC District 3 area, alternate II cementing must be completed within 30 days of the spud date or the well shall be plugged. in all cases, NOTIFY district office prior to any cementing.

I hereby certify that the statements made herein are true and to the best of my knowledge and belief.

Date: 8/27/03 Signature of Operator or Agent: W.R. Horigan Title: Vice President-Operations

Remember to:

- File Drill Pit Application (form CDP-1) with Intent to Drill;
- File Completion Form ACO-1 within 120 days of spud date;
- File acreage attribution plat according to field proration orders;
- Notify appropriate district office 48 hours prior to workover or re-entry;
- Submit plugging report (CP-4) after plugging is completed;
- Obtain written approval before disposing or injecting salt water.
- If this permit has expired (See: authorized expiration date) please check the box below and return to the address below.

Well Not Drilled - Permit Expired Signature of Operator or Agent: Date:

For KCC Use ONLY API # 15 - 015.19381.00.01 Conductor pipe required NONE feet Minimum surface pipe required 667 feet per Alt. 1 Approved by: RJP 9.9.03 This authorization expires: 3-9-04 / 9-8-04 RJP (This authorization void if drilling not started within 6 months of effective date.) Spud date: Agent:

Mail to: KCC - Conservation Division, 130 S. Market - Room 2078, Wichita, Kansas 67202

RECEIVED

SEP 09 2003

KCC WICHITA

9 25 SE

RECEIVED

SEP 05 2003

KCC WICHITA

Side Two

IN ALL CASES PLOT THE INTENDED WELL ON THE PLAT BELOW

Plat of acreage attributable to a well in a prorated or spaced field

If the intended well is in a prorated or spaced field, please fully complete this side of the form. If the intended well is in a prorated or spaced field complete the plat below showing that the well will be properly located in relationship to other wells producing from the common source of supply. Please show all the wells and within 1 mile of the boundaries of the proposed acreage attribution unit for gas wells and within 1/2 mile of the boundaries of the proposed acreage attribution unit for oil wells.

API No. 15 - _____
Operator: Vess Oil Corporation
Lease: Wilson A
Well Number: 340 OWWO
Field: El Dorado

Number of Acres attributable to well: _____
QTR / QTR / QTR of acreage: W/2 - SW - NW

Location of Well: County: Butler
1890 feet from N / S Line of Section
400 feet from E / W Line of Section
Sec. 9 Twp. 25 S. R. 05 East West



Is Section: Regular or Irregular

If Section is Irregular, locate well from nearest corner boundary.

Section corner used: NE NW SE SW

PLAT

*(Show location of the well and shade attributable acreage for prorated or spaced wells.)
(Show footage to the nearest lease or unit boundary line.)*

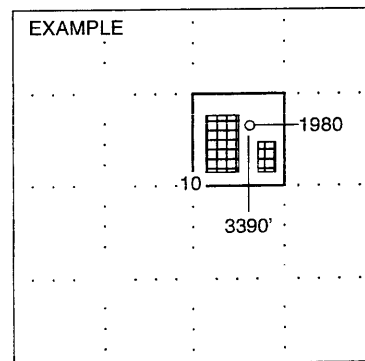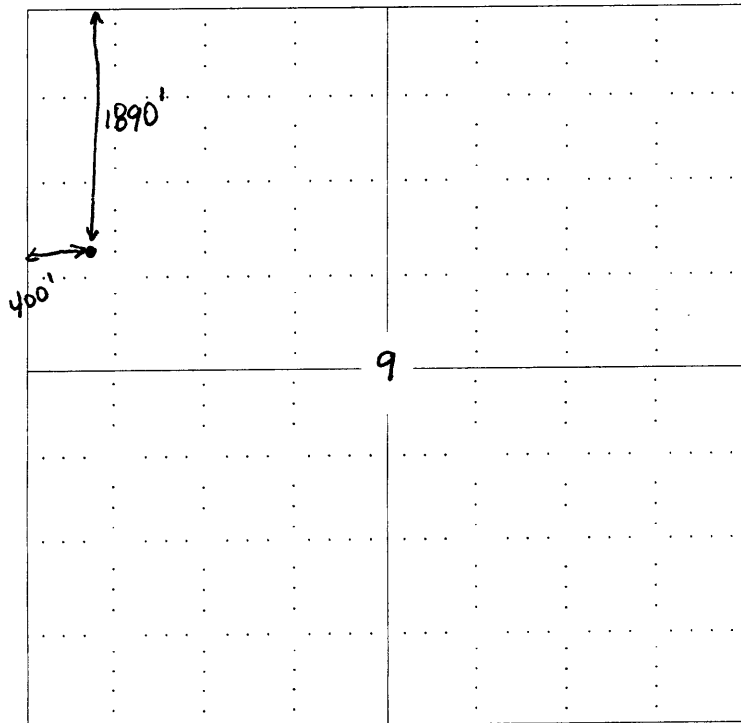

RECEIVED
SEP 09 2003
KCC WICHITA

NOTE: In all cases locate the spot of the proposed drilling location.

In plotting the proposed location of the well, you must show:

1. The manner in which you are using the depicted plat by identifying section lines, i.e. 1 section, 1 section with 8 surrounding sections, 4 sections, etc.
2. The distance of the proposed drilling location from the section's south / north and east / west.
3. The distance to the nearest lease or unit boundary line.
4. If proposed location is located within a prorated or spaced field a certificate of acreage attribution plat must be attached: (CO-7 for oil wells; CG-8 for gas wells).