

CARD MUST BE TYPED

State of Kansas  
NOTICE OF INTENTION TO DRILL  
HUGOTON INFILL

CARD MUST BE SIGNED

SEP 18 2003  
SGA-NO

EFFECTIVE DATE 9.24.03

Starting Date 09 22 03  
month day year

API Number 15- 129-21716-000  
IS SECTION X REGULAR IRREGULAR

CONSERVATION DIVISION  
WICHITA, KS

OPERATOR: License # 5952  
Name BP AMERICA PRODUCTION COMPANY  
Address P. O. BOX 3092, WL1, RM 3.201  
City/State/Zip HOUSTON, TX 77253-3092  
Contact Person SUE SELLERS  
Phone (281) 366-2052

4 SW SW NE NE Sec 13 Twp 31S S. Rg 40W W  
1250 N Ft. from South Line of Section  
1250 E Ft. from East Line of Section

CONTRACTOR License # 5382  
Name CHEYENNE DRILLING  
City/State \_\_\_\_\_

Note: Attach acreage attribution plat locating both Chase (Hugoton) wells  
Total number of acres attributed to unit 640

Well Drilled as:  New  Recompletion  OWWO  
Projected Total Depth 2780 feet  
Formation CHASE

Nearest producing well from  
same common source of supply 1799 feet  
Nearest lease or unit boundary line 1250 N feet  
County MORTON

If OWWO or Recompletion: old well info as follows:  
Operator \_\_\_\_\_  
Well Name \_\_\_\_\_  
Comp. Date \_\_\_\_\_ Old Total Depth \_\_\_\_\_

Lease Name BOND GAS UNIT Well # 4HI  
Ground surface elevation 3235 feet MSL  
Depth to bottom of fresh water 300  
Depth to bottom of usable water 580  
Surface pipe by Alternate: 1 X 2  
Surface pipe planned to be set 600' Min  
Water Source for Drilled Operations:  
DWR Permit #: \_\_\_\_\_ well \_\_\_\_\_ farm pond  other \_\_\_\_\_

I certify that well will comply with K.S.A. 55-101, et seq., plus eventually plugging hole to KCC specifications.  
Date 09/17/03 Signature of Operator or Agent Sue Sellers

Title REGULATORY STAFF ASSISTANT


For KCC Use:  
Conductor Pipe Required NONE feet; Minimum Surface Pipe Required 600 feet per Alt 1  
This Authorization Expires 3.19.04 / 9.19.04 (REV) Approved By RJP 9.19.03

9/95

Permit Extension Request Received 2-6-04

Must be filed with K.C.C. five (5) days prior to commencing well  
This card void if drilling not started within six (6) months of date received by K.C.C.

A Regular Section of Land  
1 Mile = 5,280 Ft.

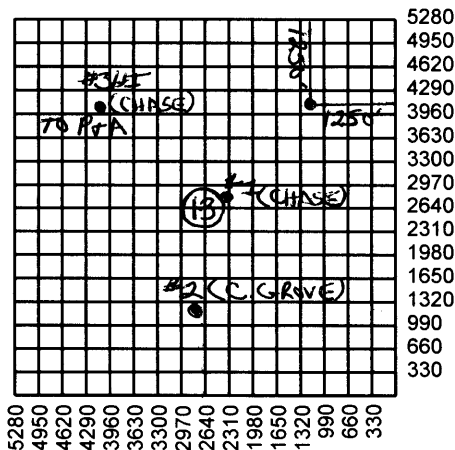

Important procedures to follow:

1. Notify District office before setting surface casing.
2. Set surface casing by circulating cement to the top.
3. File completion forms ACO-1 with K.C.C. within 120 days of well spud date, following instructions on ACO-1, side 1, and including copies of wireline logs.
4. Notify District office 48 hours prior to old well workover or re-entry.
5. Submit plugging report (CP-4) to K.C.C. after plugging is completed.
6. If an alternate 2 completion, cement in the production pipe from below any useable water to surface within 120 day of spud date.

State Corporation Commission of Kansas  
Conservation Division  
130 S. Market Room 2078  
Wichita, Kansas 67202-1212  
(316) 337-6231