

CARD MUST BE TYPED

State of Kansas  
NOTICE OF INTENTION TO DRILL  
HUGOTON INFILL

CARD MUST BE SIGNED  
KANSAS CORPORATION COMMISSION SGA-NO

EFFECTIVE DATE 9-24-03

SEP 16 2003

Starting Date 09 22 2003  
month day year

API Number 15- 129-21717-00 00

IS SECTION X. REGISTRATION DIVISION  
WICHITA, KS

OPERATOR: License # 5952  
Name BP AMERICA PRODUCTION COMPANY  
Address P. O. BOX 3092, WLL, RM 3.201  
City/State/Zip HOUSTON, TX 77253-3092  
Contact Person SUE SELLERS  
Phone (281) 366-2052

NW NW SE SE Sec 31 Twp 31S S, Rg 39W W  
1250 S Ft. from South Line of Section  
1250 E Ft. from East Line of Section

CONTRACTOR License # 5382  
Name CHEYENNE DRILLING

Note: Attach acreage attribution plat locating both Chase (Hugoton) wells  
Total number of acres attributed to unit 640

City/State  
Well Drilled as:  New  Recompletion  OWWO

Nearest producing well from  
same common source of supply 1539 feet  
Nearest lease or unit boundry line 1250 S feet

Projected Total Depth 2810' feet  
Formation HUGOTON/CHASE

County MORTON  
Lease Name MILBURN 'B' Well # 3HI  
Ground surface elevation 3258 feet MSL

If OWWO or Recompletion: old well info as follows:  
Operator  
Well Name  
Comp. Date Old Total Depth

Depth to bottom of fresh water 300  
Depth to bottom of usable water 580

Surface pipe by Alternate: 1  2  
Surface pipe planned to be set 600' MIN

Water Source for Drilled Operations:  
DWR Permit #: well farm pond  other

I certify that well will comply with K.S.A. 55-101, et seq., plus eventually plugging hole to KCC specifications.  
Date 09/15/03 Signature of Operator or Agent Title


REGULATORY STAFF  
ASSISTANT

For KCC Use:  
Conductor Pipe Required NONE feet; Minimum Surface Pipe Required 600' feet per Alt 1  
This Authorization Expires 3-19-04/9-19-04 (RSP) Approved By RSP 9-19-03 9/95

Must be filed with K.C.C. five (5) days prior to commencing well  
This card void if drilling not started within six (6) months of date received by K.C.C.

Permit Extension Request Received 2-6-04

A Regular Section of Land  
1 Mile = 5,280 Ft.

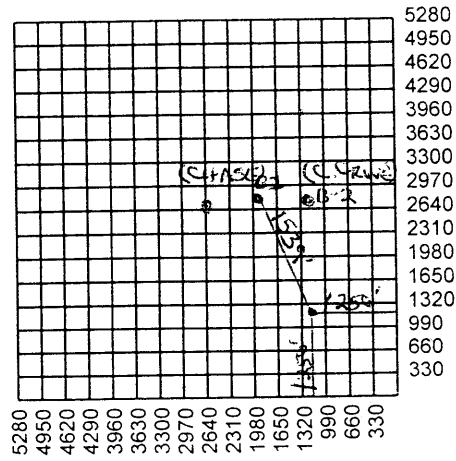

- Important procedures to follow:
1. Notify District office before setting surface casing.
  2. Set surface casing by circulating cement to the top.
  3. File completion forms ACO-1 with K.C.C. within 120 days of well spud date, following instructions on ACO-1, side 1, and including copies of wireline logs.
  4. Notify District office 48 hours prior to old well workover or re-entry.
  5. Submit plugging report (CP-4) to K.C.C. after plugging is completed.
  6. If an alternate 2 completion, cement in the production pipe from below any useable water to surface within 120 day of spud date.

State Corporation Commission of Kansas  
Conservation Division  
130 S. Market Room 2078  
Wichita, Kansas 67202-1212  
(316) 337-6231