

first loc
CORRECTED

RECEIVED

NOV 10 2003

*corrected 11-6-03

CARD MUST BE TYPED

State of Kansas

KCC WICHITA

CARD MUST BE SIGNED

EFFECTIVE DATE 9-14-03

NOTICE OF INTENTION TO DRILL
HUGOTON INFILL

Starting Date 11 month 13 day 03 year

API Number 15 - 175-21906-00-00

OPERATOR: License # 5447
Name OXY USA Inc.
Address P.O. Box 2528
City/State/Zip Liberal, KS 67901
Contact Person Cal. Wylie
Phone 620-629-4200

IS SECTION X REGULAR IRREGULAR
NW SE NE Sec. 9 Twp. 32 S, Rg. 34 W
*3380 Ft. from South Line of Section
*1250 Ft. from East Line of Section

CONTRACTOR: License # Will advise on ACO-1
Name
City/State
Well Drilled as: X New Recompletion OWWO
Projected Total Depth 2900 feet
Formation Hugoton Chase
If OWWO or Recompletion: old well info as follows:
Operator
Well Name
Comp. Date Old Total Depth

NOTE: Attach acreage attribution plat locating both Chase (Hugoton) wells
Total number of acres attributed to unit 640
Nearest producing well from
same common source of supply *2583 feet
Nearest lease or unit boundary line 1250 feet
County Seward
Lease Name Downing A Well # 4
Ground surface elevation *2848.3 feet MSL
Depth to bottom of fresh water 400
Depth to bottom of usable water 540
Surface pipe by Alternate: 1 X 2
Surface pipe planned to be set 800
Water Source for Drilled Operations:
DWR Permit #: well farm pond X other

I certify that well will comply with K.S.A. 55-101, et seq., plus eventually plugging hole to KCC specifications.
Date 11-06-03 Signature of Operator or Agent W. J. Gander Title The Capital Project

For KCC Use:


Conductor Pipe Required None feet; Minimum Surface Pipe Required 560 feet per Alt 1
This Authorization Expires 3-9-04 Approved By RSP 9-9-03 / EJP 11-14-03

Location was: 4030 fsl, 3930 fcl, SWSW NE NW
Location is: 3380 fsl, 1250 fcl, NWSE NE

9/95

Must be filed with K.C.C. five (5) days prior to commencing well
This card void if drilling not started within six (6) months of date received by K.C.C.

A Regular Section of Land
1 Mile = 5,280 Ft.

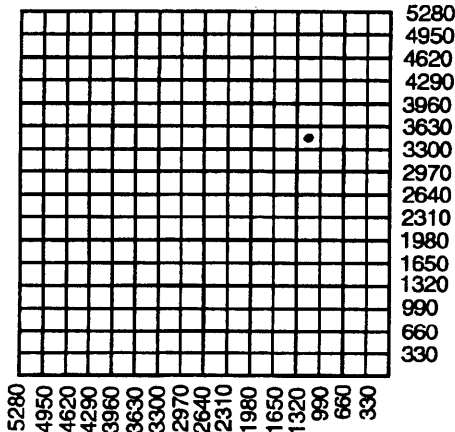

Important procedures to follow:

1. Notify District office before setting surface casing.
2. Set surface casing by circulating cement to the top.
3. File completion forms ACO-1 with K.C.C. within 120 days of well spud date, following instructions on ACO-1, side 1, and including copies of wireline logs.
4. Notify District office 48 hours prior to old well workover or re-entry.
5. Submit plugging report (CP-4) to K.C.C. after plugging is completed.
6. If an alternate 2 completion, cement in the production pipe from below any useable water to surface within 120 days of spud date.

State Corporation Commission of Kansas
Conservation Division
130 S. Market Room 2078
Wichita, Kansas 67202-1212
(316) 337-6231