

\*corrected 11-06-03

Second corr.  
**CORRECTED**

CARD MUST BE TYPED

State of Kansas  
**NOTICE OF INTENTION TO DRILL  
HUGOTON INFILL**

CARD MUST BE SIGNED

**RECEIVED**

EFFECTIVE DATE 11-4-03

NOV 10 2003

**KCC WICHITA**

Starting Date 11 28 03  
month day year

API Number 15 - 093 - 21745 - 00 - 00

OPERATOR: License # 5447  
Name OXY USA Inc.  
Address P.O. Box 2528  
City/State/Zip Liberal, KS 67901  
Contact Person Cal Wylie  
Phone 620-629-4200

IS SECTION X REGULAR IRREGULAR  
Ap E/2 SE NW SW Sec. 12 Twp. 24 S, Rg. 35 W  
\*1740 Ft. from South Line of Section  
4030 Ft. from East Line of Section

CONTRACTOR: License # Will advise on ACO-1  
Name  
City/State

NOTE: Attach acreage attribution plat locating both Chase (Hugoton) wells  
Total number of acres attributed to unit 640

Well Drilled as:  New  Recompletion  OWWO  
Projected Total Depth 2800 feet  
Formation Hugoton Chase

Nearest producing well from  
same common source of supply \*2574 feet  
Nearest lease or unit boundary line 1250 feet

If OWWO or Recompletion: old well info as follows:  
Operator  
Well Name  
Comp. Date Old Total Depth

County Kearny  
Lease Name Garden City F Well # 4  
Ground surface elevation \*2937.7 feet MSL

I certify that well will comply with K.S.A. 55-101, et seq., plus eventually plugging hole to KCC specifications.  
Date 11-6-03 Signature of Operator or Agent Willa Conder Title The Capital Project

Depth to bottom of fresh water 450  
Depth to bottom of usable water 880  
Surface pipe by Alternate: 1X 2


Surface pipe planned to be set 900'  
Water Source for Drilled Operations:  
DWR Permit #: well farm pond  other

For KCC Use:  
Conductor Pipe Required NONE feet; Minimum Surface Pipe Required 900 feet per Alt. 1  
This Authorization Expires 4-30-04 Approved By RJP 10-30-03/10-31-03/11-11-03  
9/95

Location was: 1250 fsl, 4030 fel, SW-NW-SW  
Location is: 1740 fsl, 4030 fel, E/2 SE NW SW

Must be filed with K.C.C. five (5) days prior to commencing well  
This card void if drilling not started within six (6) months of date received by K.C.C.

A Regular Section of Land  
1 Mile = 5,280 Ft.

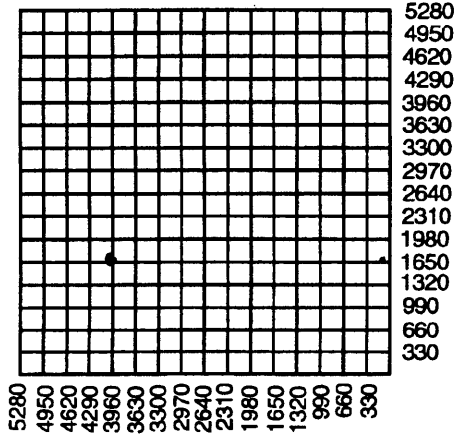

- Important procedures to follow:
1. Notify District office before setting surface casing.
  2. Set surface casing by circulating cement to the top.
  3. File completion forms ACO-1 with K.C.C. within 120 days of well spud date, following instructions on ACO-1, side 1, and including copies of wireline logs.
  4. Notify District office 48 hours prior to old well workover or re-entry.
  5. Submit plugging report (CP-4) to K.C.C. after plugging is completed.
  6. If an alternate 2 completion, cement in the production pipe from below any useable water to surface within 120 days of spud date.

State Corporation Commission of Kansas  
Conservation Division  
130 S. Market Room 2078  
Wichita, Kansas 67202-1212  
(316) 337-6231