

RECEIVED

JAN 02 2004

KCC WICHITA

For KCC Use: Effective Date: 1-7-04 District # 3 SGA?  Yes  No

KANSAS CORPORATION COMMISSION OIL & GAS CONSERVATION DIVISION

Form C-1 September 1999

Form must be Typed Form must be Signed blanks must be Filled

NOTICE OF INTENT TO DRILL Must be approved by KCC rive (5) days prior to commencing well

Expected Spud Date January 7 2004 month day year

Spot NW - SE - SW Sec 22 Twp. 26 S. R. 18 East West 1050 feet from SYM (circle one) Line of Section 3700 feet from E/W (circle one) Line of Section Is SECTION X Regular Irregular?

OPERATOR: License# 5488 Name: TWM Production Company Address: 1150 Highway 39 City/State/Zip: Chanute, Kansas 66720 Contact Person: Michael or Carol Wimsett Phone: 620-431-4137

(Note: Locate well on the Section Plat on reverse side) County: Allen Lease Name: DICE Well #: D-10 Field Name: Humboldt/Chanute

CONTRACTOR: License# 5491 Name: W & W Production Company

Is this a Prorated / Spaced Field?  Yes  No Target Information(s): Bartlesville Nearest Lease or unit boundary: 1050

Well Drilled For: Oil Gas OWWO Seismic Other Well Class: Enh Rec Storage Disposal # of Holes Infield Pool Ext Wildcat Other Type Equipment: Mud Rotary Air Rotary Cable

Ground Surface Elevation: N/A feet MSL Water well within one-quarter mile:  Yes  No Public water supply well within one mile:  Yes  No

If OWWO: old well information as follows: Operator: Well Name: Original Completion Date: Original Total Depth:

Depth to bottom of fresh water: 100 Depth to bottom of usable water: 150 Surface Pipe by Alternate: 1 X 2 Length of Surface Pipe Planned to be set: 20

Directional, Deviated or Horizontal wellbore?  Yes  No If Yes, true vertical depth: Bottom Hole Location: KCC DKT #:

Length of Conductor Pipe required: N/A NONE Projected Total Depth: 1000 Producing Formation Target: Bartlesville Water Source for Drilling Operations: Well Farm Pond X Other

DWR Permit #: Will Cores be taken?  Yes  No If Yes, proposed zone:

AFFIDAVIT

The undersigned hereby affirms that the drilling, completion and eventual plugging of this well will comply with K.S.A. 55-101, et. seq. It is agreed that the following minimum requirements will be met:

- 1. Notify the appropriate district office prior to spudding of well; 2. A copy of the approved notice of intent to drill shall be posted on each drilling rig; 3. The minimum amount of surface pipe as specified below shall be set by circulating cement to the top... 4. If the well is dry hole, an agreement between the operator and the district office on plug length and placement is necessary prior to plugging; 5. The appropriate district office will be notified before well is either plugged or production casing is cemented in; 6. If an ALTERNATE II COMPLETION, production pipe shall be cemented from below any usable water to surface within 120 days of spud date. In all cases, NOTIFY district office prior to any cementing.

I hereby certify that the statements made herein are true and to the best of my knowledge and belief. Date: DEC. 29, 2003 Signature of Operator or Agent: Carol Wimsett Title: Office Manager

For KCC Use ONLY API # 15 - 001-29066.00.00 Conductor pipe required NONE feet Minimum surface pipe requir 20 feet per Alt. 2 Approved by: RJP 1-2-04 This authorization expires: 7-2-04 (This authorization void if drilling not started within 6 months of effective date.) Spud date: Agent:

- Remember to: - File Drill Pit Application (form CDP-1) with Intent to Drill; - File Completion Form ACO-1 within 120 days of spud date; - File acreage attribution plat according to field proration orders; - Notify appropriate district office 48 hours prior to workover or re-entry; - Submit plugging report (CP-4) after plugging is completed; - Obtain written approval before disposing or injecting salt water.

22 26 18E

RECEIVED

JAN 02 2004

KCC WICHITA

**IN ALL CASES PLOT THE INTENDED WELL ON THE PLAT BELOW**

*Plat of acreage attributable to a well in a prorated or spaced field*

**If the intended well is in a prorated or spaced field, please fully complete this side of the form.** If the intended well is in a prorated or spaced field complete the plat below showing that the well will be properly located in relationship to other wells producing from the common source of supply. Please show all the wells and within 1 mile of the boundaries of the proposed acreage attribution unit for gas wells and within 1/2 mile of the boundaries of the proposed acreage attribution unit for oil wells.

API No. 15 - \_\_\_\_\_  
 Operator: Twm<sup>3</sup> Production Co.  
 Lease: DICE  
 Well Number: D-10 /  
 Field: HUMBOLDT/CHANUTE  
 Number of Acres attributable to well: \_\_\_\_\_  
 QTR / QTR / QTR of acreage: \_\_\_\_\_ - \_\_\_\_\_ - \_\_\_\_\_

Location of Well: County: ALLEN  
 1050 \_\_\_\_\_ feet from  N /  S Line of Section  
 3700 \_\_\_\_\_ feet from  E /  W Line of Section  
 Sec. 22 Twp. 26 S. R. 18  East  West



Is Section:  Regular or  Irregular

**If Section is Irregular, locate well from nearest corner boundary.**

Section corner used:  NE  NW  SE  SW

**PLAT**

*(Show location of the well and shade attributable acreage for prorated or spaced wells.)  
(Show footage to the nearest lease or unit boundary line.)*

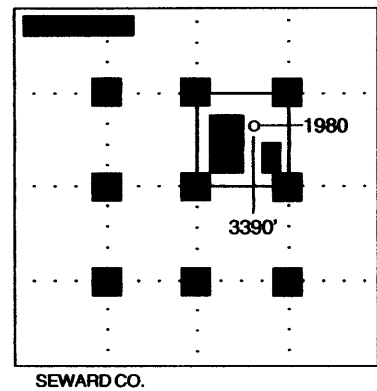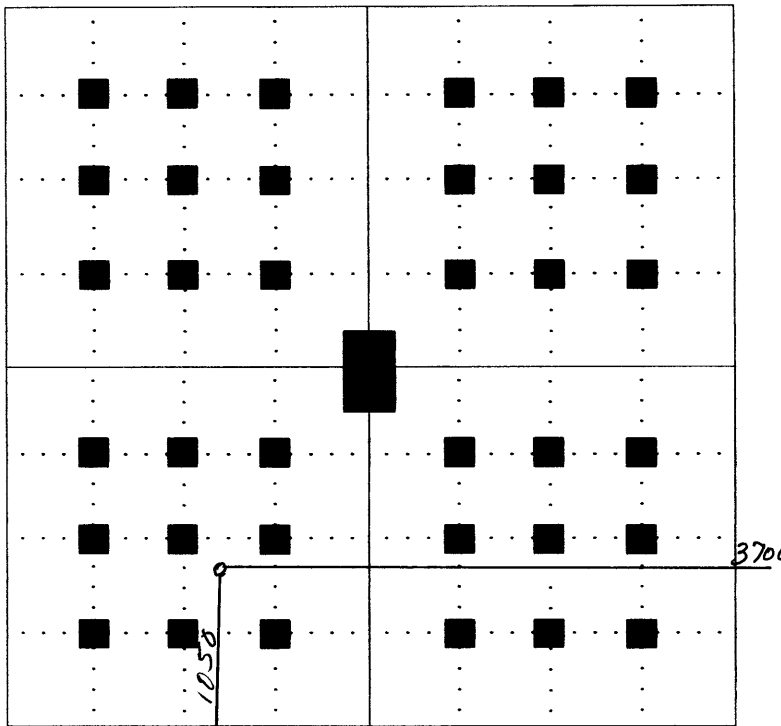

**NOTE: In all cases locate the spot of the proposed drilling location.**

*Section 22*

**In plotting the proposed location of the well, you must show:**

1. The manner in which you are using the depicted plat by identifying section lines, i.e. 1 section, 1 section with 8 surrounding sections, 4 sections, etc.
2. The distance of the proposed drilling location from the section's south / north and east / west.
3. The distance to the nearest lease or unit boundary line.
4. If proposed location is located within a prorated or spaced field a certificate of acreage attribution plat must be attached: (C0-7 for oil wells; CG-8 for gas wells).