

OWWO

RECEIVED

DEC 29 2003

For KCC Use: 1-3-04
Effective Date:
District #: 4
SGA? Yes No

KANSAS CORPORATION COMMISSION
OIL & GAS CONSERVATION DIVISION
NOTICE OF INTENT TO DRILL

KCC WICHITA

Form C-1
December 2002
Form must be Typed
Form must be Signed
All blanks must be Filled

Must be approved by KCC five (5) days prior to commencing well

Expected Spud Date January 5th 2004
month day year

OPERATOR: License# 6039
Name: L.D. DRILLING, INC.
Address: 7 sw 26TH AVENUE
City/State/Zip: GREAT BEND,
Contact Person: L. D. Davis
Phone: (316) 793-3051

CONTRACTOR: License# 6426
Name: Express Well Service

Well Drilled For: Oil Gas OWO Seismic Other
Well Class: Enh Rec Storage Disposal
Type Equipment: Infield Pool Ext Wildcat Cable
Mud Rotary Air Rotary
PULLING UNIT - Express Well Service

If OWWO: old well information as follows:
Operator: Misco Supply Company
Well Name: Miller #5
Original Completion Date: 11-02-47 Original Total Depth: 3583'
Directional, Deviated or Horizontal wellbore? Yes No
Bottom Hole Location:
KCC DKT #:

Spot SE NW NW Sec. 9 Twp. 19 S. R. 15
990 feet from N / S Line of Section
990 feet from E / W Line of Section
Is SECTION Regular Irregular?

(Note: Locate well on the Section Plat on reverse side)
County: BARTON
Lease Name: MILLER "BB" owwo Well #: 1
Field Name: Otis - Albert
Is this a Prorated / Spaced Field? Yes No
Target Formation(s): Herrington Krider Gas
Nearest Lease or unit boundary: 990'
Ground Surface Elevation: 1974' feet MSL
Water well within one-quarter mile: Yes No
Public water supply well within one mile: Yes No
Depth to bottom of fresh water: 150' 180'
Depth to bottom of usable water: 280' 320'
Surface Pipe by Alternate: 1 2
Length of Surface Pipe Planned to be set: 958' in hole
Length of Conductor Pipe required: none
Projected Total Depth: 2500'
Formation at Total Depth: Herrington Krider
Water Source for Drilling Operations: Well Farm Pond Other Haul
DWR Permit #:
Will Cores be taken? Yes No
If Yes, proposed zone:

AFFIDAVIT

The undersigned hereby affirms that the drilling, completion and eventual plugging of this well will comply with K.S.A. 55 et. seq.

It is agreed that the following minimum requirements will be met:

- 1. Notify the appropriate district office prior to spudding of well;
2. A copy of the approved notice of intent to drill shall be posted on each drilling rig;
3. The minimum amount of surface pipe as specified below shall be set by circulating cement to the top; in all cases surface pipe shall be set through all unconsolidated materials plus a minimum of 20 feet into the underlying formation.
4. If the well is dry hole, an agreement between the operator and the district office on plug length and placement is necessary prior to plugging;
5. The appropriate district office will be notified before well is either plugged or production casing is cemented in;
6. If an ALTERNATE II COMPLETION, production pipe shall be cemented from below any usable water to surface within 120 days of spud date.
Or pursuant to Appendix "B" - Eastern Kansas surface casing order #133,891-C, which applies to the KCC District 3 area, alternate II cementing must be completed within 30 days of the spud date or the well shall be plugged. In all cases, NOTIFY district office prior to any cementing.

I hereby certify that the statements made herein are true and to the best of my knowledge and belief.

Date: 12-24-03 Signature of Operator or Agent: Bessie Dewitt Title: Sec/Treas

For KCC Use ONLY
API # 15 - 009-07141-00-01
Conductor pipe required NONE feet
Minimum surface pipe required 958 feet per Alt. 1
Approved by: RSP12-29-03
This authorization expires: 6-29-04
Spud date: Agent:

Remember to:

- File Drill Pit Application (form CDP-1) with Intent to Drill;
- File Completion Form ACO-1 within 120 days of spud date;
- File acreage attribution plat according to field proration orders;
- Notify appropriate district office 48 hours prior to workover or re-entry;
- Submit plugging report (CP-4) after plugging is completed;
- Obtain written approval before disposing or injecting salt water.
- If this permit has expired (See: authorized expiration date) please check the box below and return to the address below.

Well Not Drilled - Permit Expired

Signature of Operator or Agent:
Date:

Mail to: KCC - Conservation Division, 130 S. Market - Room 2078, Wichita, Kansas 67202

9
19
15w

RECEIVED

DEC 29 2003

KCC WICHITA

**IN ALL CASES PLOT THE INTENDED WELL ON THE PLAT BELOW**

*Plat of acreage attributable to a well in a prorated or spaced field*

**If the intended well is in a prorated or spaced field, please fully complete this side of the form.** If the intended well is in a prorated or spaced field complete the plat below showing that the well will be properly located in relationship to other wells producing from the common source of supply. Please show all the wells and within 1 mile of the boundaries of the proposed acreage attribution unit for gas wells and within 1/2 mile of the boundaries of the proposed acreage attribution unit for oil wells.

API No. 15 - \_\_\_\_\_  
Operator: L.D. DRILLING, INC.  
Lease: MILLER "BB" owwo  
Well Number: 1  
Field: \_\_\_\_\_

Location of Well: County: BARTON  
990 feet from  N /  S Line of Section  
990 feet from  E /  W Line of Section  
Sec. 9 Twp. 19 S. R. 15  East  West



Number of Acres attributable to well: 10  
QTR / QTR / QTR of acreage: SE - NW - NW

Is Section:  Regular or  Irregular

**If Section Is Irregular, locate well from nearest corner boundary.**  
Section corner used:  NE  NW  SE  SW

**PLAT**

*(Show location of the well and shade attributable acreage for prorated or spaced wells.)  
(Show footage to the nearest lease or unit boundary line.)*

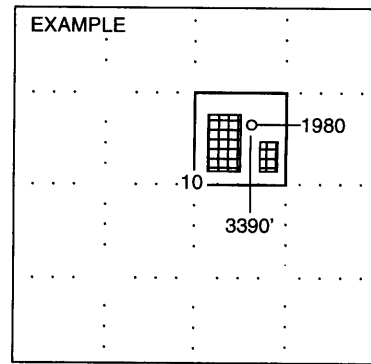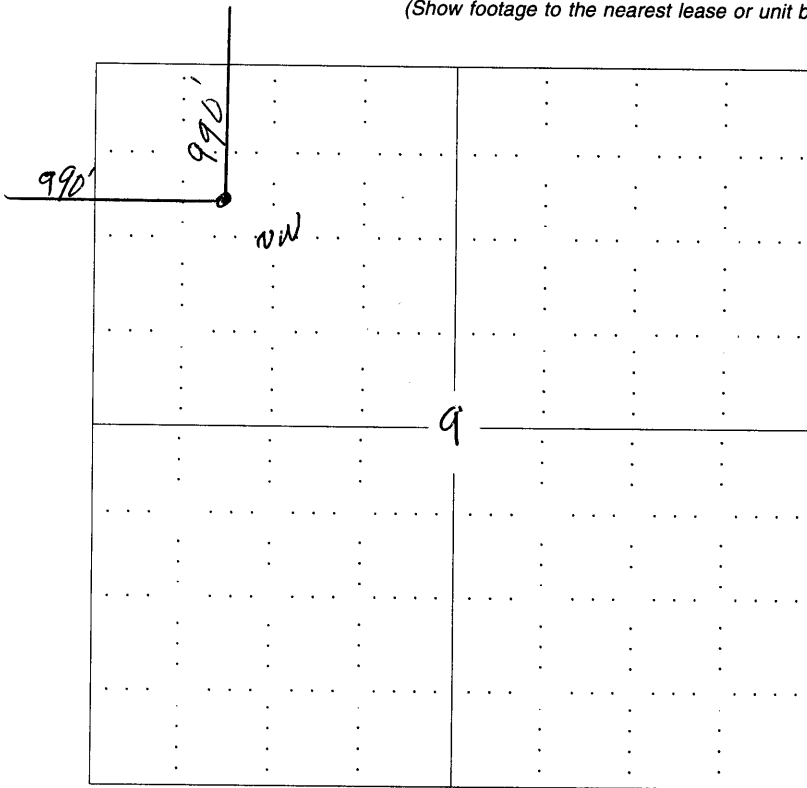

**NOTE: In all cases locate the spot of the proposed drilling locaton.**

**In plotting the proposed location of the well, you must show:**

1. The manner in which you are using the depicted plat by identifying section lines, i.e. 1 section, 1 section with 8 surrounding sections, 4 sections, etc.
2. The distance of the proposed drilling location from the section's south / north and east / west.
3. The distance to the nearest lease or unit boundary line.
4. If proposed location is located within a prorated or spaced field a certificate of acreage attribution plat must be attached: (CO-7 for oil wells; CG-8 for gas wells).