

FOR KCC USE:

KANSAS CORPORATION COMMISSION
OIL & GAS CONSERVATION DIVISION

FORM C-1 12/02

FORM MUST BE TYPED

EFFECTIVE DATE: 2-1-04

NOTICE OF INTENT TO DRILL

FORM MUST BE SIGNED

ALL BLANKS MUST BE FILLED

DISTRICT # 3 MUST BE APPROVED BY THE KCC FIVE DAYS PRIOR TO COMMENCING WELL

SGA? X.Yes. 2

Expected Spud Date ... 1 ..28.....2004..... APE/2 SE. NE. SE. Sec ..2 . Twp ..23. S, Rg ..16. X East
month day year

OPERATOR: License #5150.....
Name:COLT ENERGY, INC.....
Address:P O BOX 388.....
City/State/Zip:IOLA, KANSAS..66749.....
Contact Person: ..DENNIS KERSHNER.....
Phone:316 365-3111.....

.....1720..... feet from South line of Section
..... 140..... feet from East line of Section
IS SECTION _____ REGULAR X IRREGULAR?
(NOTE: Locate well on the Section Plat on Reverse Side)
County:COFFEY

CONTRACTOR: License #: ...30567.....
Name: ...RIG 6 DRILLING CO, INC.....

Lease Name: ...MURRAY..... Well #: ..WDW1.....
Field Name:NEOSHO FALLS - LEROY.....
Is this a Prorated/Spaced Field? yes X.. no
Target Formation(s):ARBUCKLE.....
Nearest lease or unit boundary:140.....
Ground Surface Elevation:993..... feet MSL
Water well within one-quarter mile: yes X.. no
Public water supply well within one mile: yes X.. no
Depth to bottom of fresh water:150.....
Depth to bottom of usable water: ...200.....
Surface Pipe by Alternate: 1 ..X. 2
Length of Surface Pipe Planned to be set:40'.....
Length of Conductor pipe required:NONE.....
Projected Total Depth:2100.....
Formation at Total Depth:ARBUCKLE.....
Water Source for Drilling Operations:
... well ..X. farm pond other
Will Cores Be Taken? .. yes X.. no
If yes, proposed zone:

Well Drilled For Well Class: Type Equipment:
... Oil ... Enh Rec .X. Infield .X. Mud Rotary
... Gas ... Storage ... Pool Ext. ... Air Rotary
... OWWO .X. Disposal ... Wildcat ... Cable
... Seismic; ... # of Holes ... Other
... Other

If OWWO: old well information as follows:

Operator:
Well Name:
Comp. Date: Old Total Depth
Directional, Deviated or Horizontal wellbore? yes X.. no
If yes, true vertical depth:.....
Bottom Hole Location.....

AFFIDAVIT

The undersigned hereby affirms that the drilling, completion and eventual plugging of this well will comply with K.S.A. 55-101, et. seq.

It is agreed that the following minimum requirements will be met:

1. Notify the appropriate district office prior to spudding of well;
2. A copy of the approved notice of intent to drill shall be posted on each drilling rig;
3. The minimum amount of surface pipe as specified below shall be set by circulating cement to the top; in all cases surface pipe shall be set through all unconsolidated materials plus a minimum of 20 feet into the underlying formation;
4. If the well is dry hole, an agreement between the operator and the district office on plug length and placement is necessary prior to plugging;
5. The appropriate district office will be notified before well is either plugged or production casing is cemented in;
6. IF AN ALTERNATE II COMPLETION, PRODUCTION PIPE SHALL BE CEMENTED FROM BELOW ANY USABLE WATER TO SURFACE WITHIN 120 DAYS OF SPUD DATE. Or pursuant to Appendix B Eastern Kansas surface casing order #133,891-C, which applies to the KCC District 3 area, alternate II cementing must be completed within 30 days of the spud date or the well shall be plugged. IN ALL CASES, NOTIFY DISTRICT OFFICE PRIOR TO ANY CEMENTING.

I hereby certify that the statements made herein are true and to the best of my knowledge and belief.

Date: ...1/20/2004..... Signature of Operator or Agent: Dennis Kershner Title...OFFICE MANAGER.....

FOR KCC USE:
API # 15- 031-22002-00-00
Conductor pipe required NONE feet
Minimum surface pipe required 40 feet per Alt. 2
Approved by: RSP 1-27-04
This authorization expires: 7-27-04
(This authorization void if drilling not started within 6 months of effective date.)
Spud date: _____ Agent: _____

RECEIVED

JAN 26 2004

KCC WICHITA

REMEMBER TO:

- File Drill Pit Application (form CDP-1) with Intent to Drill;
- File Completion Form ACO-1 within 120 days of spud date;
- File acreage attribution plat according to field proration orders;
- Notify appropriate district office 48 hours prior to workover or re-entry;
- Submit plugging report (CP-4) after plugging is completed;
- Obtain written approval before disposing or injecting salt water.

Mail to: KCC - Conservation Division, 130 S. Market - Room 2078, Wichita, Kansas 67202

Handwritten notes: 12, 23, 160

IN ALL CASES PLOT THE INTENDED WELL ON THE PLAT BELOW

PLAT OF ACREAGE ATTRIBUTABLE TO A WELL IN A PRORATED OR SPACED FIELD

If the intended well is in a prorated or spaced field, please fully complete this side of the form. If the intended well is in a prorated or spaced field complete the plat below showing that the well will be properly located in relationship to other wells producing from the common source of supply. Please show all the wells within 1 mile of the boundaries of the proposed acreage attribution unit for gas wells and within 1/2 mile of the boundaries of the proposed acreage attribution unit for oil wells.

API NO. 15- _____
 OPERATOR _____
 LEASE _____
 WELL NUMBER _____
 FIELD _____


LOCATION OF WELL: COUNTY _____
 _____ feet from south/north line of section
 _____ feet from east/west line of section
 SECTION _____ TWP _____ RG _____

NUMBER OF ACRES ATTRIBUTABLE TO WELL _____
 QTR/QTR/QTR OF ACREAGE _____ - _____ - _____

IS SECTION X REGULAR or _____ IRREGULAR
IF SECTION IS IRREGULAR, LOCATE WELL FROM NEAREST CORNER BOUNDARY.

Section corner used: _____ NE _____ NW _____ SE _____ SW
PLAT

(Show location of the well and shade attributable acreage for prorated or spaced wells.)
 (Show footage to the nearest lease or unit boundary line.)

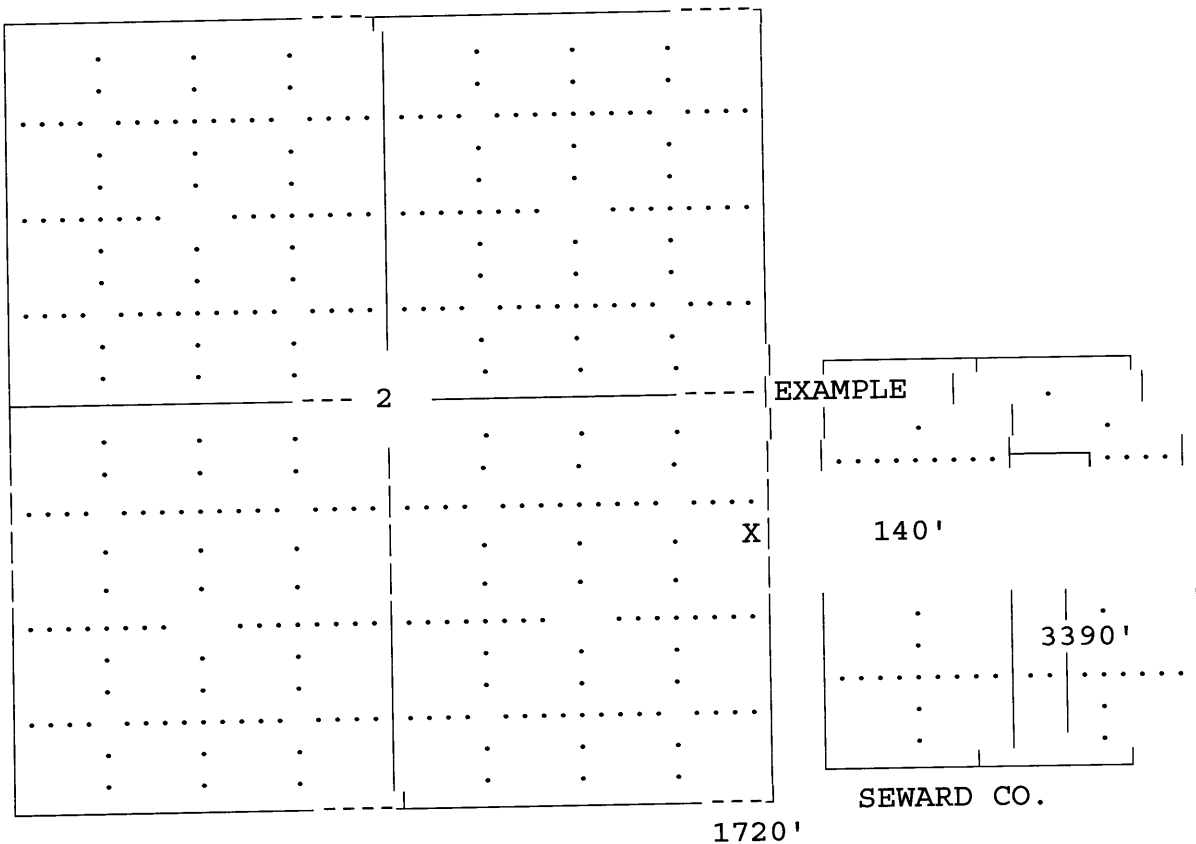

In plotting the proposed location of the well, you must show:

- 1) The manner in which you are using the depicted plat by identifying section lines, i.e. 1 section, 1 section with 8 surrounding sections, 4 sections, etc.;
- 2) The distance of the proposed drilling location from the section's south/north and east/west.
- 3) The distance to the nearest lease or unit boundary line.
- 4) If proposed location is located within a prorated or spaced field a certificate of acreage attribution plat must be
- 5) attached: (CO-7 for oil wells; CG-8 for gas wells).