

STATE CORPORATION COMMISSION OF KANSAS
OIL & GAS CONSERVATION DIVISION

WELL COMPLETION OR RECOMPLETION FORM
ACO-1 WELL HISTORY

DESCRIPTION OF WELL AND LEASE

Operator: License # 9247
Name Cincris Energy Company, Inc.
Address 625 S. Washington
City/State/Zip Great Bend, KS 67530

Purchaser FARMLAND INDUSTRIES

Operator Contact Person William Riley
Phone 316-792-8278

Contractor: License # 6394
Name Mohawk Drilling, Inc.

Wellsite Geologist ROD TREMBLAY
Phone 316-792-1583

Designate Type of Completion

- New Well Re-Entry Workover
- Oil SWD Temp Abd
- Gas Inj Delayed Comp.
- Dry Other (Core, Water Supply etc.)

If ONWO: old well info as follows:

Operator
Well Name
Comp. Date Old Total Depth

WELL HISTORY

Drilling Method:
 Mud Rotary Air Rotary Cable

11-20-84 11-24-84 12-08-84
Spud Date Date Reached TD Completion Date

3525'
Total Depth PBTD

Amount of Surface Pipe Set and Cemented at 270 feet
Multiple Stage Cementing Collar Used? Yes No
If yes, show depth set 1422 feet
If alternate 2 completion, cement circulated from 1422 feet depth to SURF w/ SX cmt

API NO. 15-147-20-463-00-00
County Phillips
100'E
NW SE NW Sec. 27 Twp. 1 Rge. 18 East West


3630 Ft North from Southeast Corner of Section
3530 Ft West from Southeast Corner of Section
(Note: Locate well in section plat below)

Lease Name Bennett Well # 2

Field Name Huffstutter

Producing Formation LKC

Elevation: Ground 2111 2121 KB
Section Plat

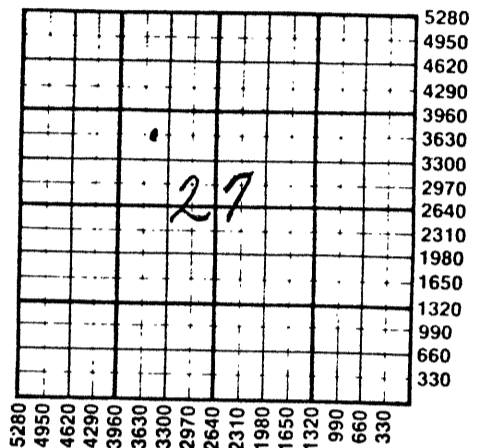

WATER SUPPLY INFORMATION

Disposition of Produced Water: Disposal Repressuring
Docket #

Questions on this portion of the ACO-1 call:

Water Resources Board (913) 296-3717
Source of Water:
Division of Water Resources Permit # N/A

Groundwater Ft North from Southeast Corner (Well) Ft West from Southeast Corner of Sec Twp Rge East West

Surface Water Ft North from Southeast Corner (Stream, pond etc) Ft West from Southeast Corner Sec Twp Rge East West

Other (explain) (purchased from city, R.W.D. #)

INSTRUCTIONS: This form shall be completed in duplicate and filed with the Kansas Corporation Commission, 200 Colorado Derby Building, Wichita, Kansas 67202, within 90 days after completion or recompletion of any well. Rule 82-3-130 and 82-3-107 apply.

Information on side two of this form will be held confidential for a period of 12 months if requested in writing and submitted with the form. See rule 82-3-107 for confidentiality in excess of 12 months. One copy of all wireline logs and drillers time log shall be attached with this form. Submit CP-4 form with all plugged wells. Submit CP-111 form with all temporarily abandoned wells.

All requirements of the statutes, rules and regulations promulgated to regulate the oil and gas industry have been fully complied with and the statements herein are complete and correct to the best of my knowledge.

Signature William V. Riley

Title President Date 1-2-85

Subscribed and sworn to before me this 2nd day of January 1985

Notary Public Charlene M. Marker

Date Commission Expires 11-14-85

Charlene M. Marker
NOTARY PUBLIC
Kansas

RECEIVED STATE CORPORATION COMMISSION
JAN 07 1985
K.C.C. OFFICE USE ONLY
F Letter of Confidentiality Attached
C Wireline Log Received
C Drillers Time Log Received
Distribution
 KCC SWD/Rep NGPA
 KGS Plug Other (Specify)

Jan 7, 1985

Operator Name Cincris Energy Company, Inc. Lease Name Bennett Well # 2

Sec. 27 Twp. 1 Rge. 18 East West County Phillips

WELL LOG

INSTRUCTIONS: Show important tops and base of formations penetrated. Detail all cores. Report all drill stem tests giving interval tested, time tool open and closed, flowing and shut-in pressures, whether shut-in pressure reached static level, hydrostatic pressures, bottom hole temperature, fluid recovery, and flow rates if gas to surface during test. Attach extra sheet if more space is needed. Attach copy of log.

Drill Stem Tests Taken Yes No
 Samples Sent to Geological Survey Yes No
 Cores Taken Yes No

Formation Description
 Log Sample

DST #1 3345-3405 45/45/45/45
 IHP 1686, FHP 1676
 IFP 51-51, FFP 62-62
 ISIP 672, FSIP 569
 REC. 20 CGO, 60' OCM (20% OIL)

Name	Top	Bottom
HEEB	-1104	
LKC	-1207	
RTD	-1404	

CASING RECORD <input checked="" type="checkbox"/> New <input type="checkbox"/> Used							
Report all strings set-conductor, surface, intermediate, production, etc.							
Purpose of String	Size Hole Drilled	Size Casing Set (in O.D.)	Weight Lbs/Ft.	Setting Depth	Type of Cement	#Sacks Used	Type and Percent Additives
Surface (n)	12 1/4"	8 5/8"	20#	270'	50/50	150	2%Gel 3%CC
Production-N	7 7/8"	4 1/2"		3511'	POZ		

PERFORATION RECORD		Acid, Fracture, Shot, Cement Squeeze Record	
Shots Per Foot	Specify Footage of Each Interval Perforated	(Amount and Kind of Material Used)	Depth
2	3365-69, 3383-85, 3401-10	7,000 gal... 15% HCl	

TUBING RECORD			
Size	Set At	Packer at	Liner Run <input type="checkbox"/> Yes <input checked="" type="checkbox"/> No
2 3/8		N/A	

Date of First Production	Producing Method				
	<input type="checkbox"/> Flowing <input checked="" type="checkbox"/> Pumping <input type="checkbox"/> Gas Lift <input type="checkbox"/> Other (explain).....				
Estimated Production Per 24 Hours	Oil	Gas	Water	Gas-Oil Ratio	Gravity
	65 Bbls	MCF	+W Bbls		CFPB

METHOD OF COMPLETION

Production Interval

Disposition of gas: Vented Open Hole Perforation
 Sold Other (Specify)
 Used on Lease Dually Completed
 Commingled