


STATE OF KANSAS
 STATE CORPORATION COMMISSION
 CONSERVATION DIVISION
 P. O. BOX 17027
 WICHITA, KANSAS 67217

13-147-20023-00-00

FORM CP-4

WELL PLUGGING RECORD

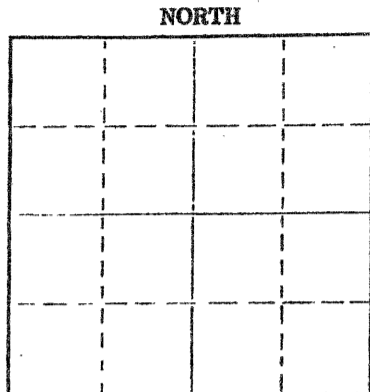

Locate well correctly on above Section Plat

Phillips County, Sec. 23 Twp. 1 Rge. 18 (E) (W)
 Location as "NE/CNW/SW" or footage from lines NW NW NE
 Lease Owner Monel B. Enterprises
 Lease Name O'Neill #1 Well No.
 Office Address Phillipsburg, Kansas
 Character of Well (completed as Oil, Gas or Dry Hole)
 Date well completed 19
 Application for plugging filed 19
 Application for plugging approved 19
 Plugging commenced 2/12/75 19
 Plugging completed 2/21/75 19
 Reason for abandonment of well or producing formation depleted.
 If a producing well is abandoned, date of last production 19
 Was permission obtained from the Conservation Division or its agents before plugging was commenced? yes

Name of Conservation Agent who supervised plugging of this well Massey
 Producing formation Depth to top Bottom Total Depth of Well 3512 Feet
 Show depth and thickness of all water, oil and gas formations.

OIL, GAS OR WATER RECORDS

CASING RECORD

FORMATION	CONTENT	FROM	TO	SIZE	PUT IN	PULLED OUT
				8-5/8	207	none
				4 1/2"	3510	1007'

Describe in detail the manner in which the well was plugged, indicating where the mud fluid was placed and the method or methods used in introducing it into the hole. If cement or other plugs were used, state the character of same and depth placed, from feet to feet for each plug set.

Ran sand to 3500' and ran 3 sacks cement. Loaded hole, shot pipe at 2712', 2610', 2417', 2222', 2024', 1814', 1624', 1400', 1200', 1018', pulled 31 joints. Plugged well with 30 sacks gel, 3 sacks hulls and 120 sacks pos cement, 6% gel.

PLUGGING COMPLETE.

(If additional description is necessary, use BACK of this sheet)

Name of Plugging Contractor KELSO CASING PULLING
 Address CHASE, KANSAS

STATE OF KANSAS COUNTY OF RICE ss.
 R. DARRELL KELSO

(employee of owner) or (owner or operator) of the above-described well, being first duly sworn on oath, says: That I have knowledge of the facts, statements, and matters herein contained and the log of the above-described well as filed and that the same are true and correct. So help me God.

(Signature) R. Darrell Kelso
 CHASE, KANSAS
 (Address)

Subscribed and sworn to before me this 24th day of February, 1975

My commission expires



Margaret Melcher
 Notary Public.

RECEIVED
 STATE CORPORATION COMMISSION

FEB 26 1975

CONSERVATION DIVISION
 Wichita, Kansas

FEB 26, 1975

ORIGINAL

KANSAS GEOLOGICAL SOCIETY
KANSAS WELL LOG BUREAU - KANSAS WELL SAMPLE BUREAU
KANSAS GEOLOGICAL SOCIETY BUILDING
508 EAST MURDOCK - WICHITA, KANSAS

STENCILED

OCT 19 1968 PANY M & B ENTERPRISES

SEC. 23 T. 1 R. 18W
LOC. NW NW NE

FARM O'Neill NO. 1

15-147-20023-00-00 COUNTY

Phillips

TOTAL DEPTH 3510'


COMM. 11-25-67

COMP. 2-8-68

SHOT OR TREATED

CONTRACTOR Red Tiger Drlg.

ISSUED 10-12-68

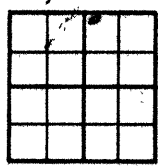

CASING

20 10
15 8 5/8" 207'
12 6
13 5

ELEVATION 2103' KB

PRODUCTION P 6 BOPD PLUS 62% W
Lans 3370-75 & 3420-24

4 1/2" 3510' cem w/ 150 sx
FIGURES INDICATE BOTTOM OF FORMATIONS

COMPLETE DRILLERS LOG NOT AVAILABLE

TOPS: LOG

Heebner 3300
Toronto 3329
Lansing 3346
TD 3510

RECEIVED
STATE CORPORATION COMMISSION
DEC 3 1974
CONSERVATION DIVISION
Wichita, Kansas