

15-47-20030-00-00


STATE OF KANSAS
STATE CORPORATION COMMISSION

WELL PLUGGING RECORD

Give All Information Completely
Make Required Affidavit
Mail or Deliver Report to
Conservation Division
State Corporation Comm.
245 North Water
Wichita, KS 67202

Phillips County. Sec. 23 Twp. 1 Rge. 18 E/W
Location as "NE/CNW $\frac{1}{4}$ SW $\frac{1}{4}$ " or footage from lines
NW SW NW

Lease Owner Don H. Peaker
Lease Name O'Neill #2 Well No. _____
Office Address Pueblo, Colorado 81002
Character of Well (Completed as Oil, Gas or Dry Hole) _____

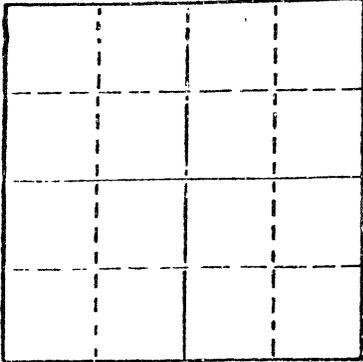

Locate well correctly on above
Section Plat

Date Well completed 19 _____
Application for plugging filed 19 _____
Application for plugging approved 19 _____
Plugging commenced 8/4/80 19 _____
Plugging completed 8/6/80 19 _____
Reason for abandonment of well or producing formation _____

depleted
If a producing well is abandoned, date of last production 19 _____

Was permission obtained from the Conservation Division or
its agents before plugging was commenced? yes _____

Name of Conservation Agent who supervised plugging of this well Schmidt
Producing formation _____ Depth to top _____ Bottom _____ Total Depth of Well 3625
Show depth and thickness of all water, oil and gas formations.

OIL, GAS OR WATER RECORDS

CASING RECORD

FORMATION	CONTENT	FROM	TO	SIZE	PUT IN	PULLED OUT
				8-5/8	218	none
				4 $\frac{1}{2}$	3623	1332

Describe in detail the manner in which the well was plugged, indicating where the mud fluid
was placed and the method or methods used in introducing it into the hold. If cement or other
plugs were used, state the character of same and depth placed, from _____ feet to
_____ feet for each plug set.

Sanded to 3575' and ran 4 sacks cement. Fluid at 300', shot pipe at
1471', 1340', pulled 42 joints. Pumped 3 sacks hulls, 8 sacks gel,
70 sacks cement, 10 sacks gel, 2 sacks hulls and 70 sacks cement.

PLUGGING COMPLETE.

(If additional description is necessary, use BACK of this sheet)

Name of Plugging Contractor KELSO CASING PULLING
CHASE, KANSAS

STATE OF KANSAS COUNTY OF RICE
R. DARREEL KELSO (employee of owner) or (owner or operator)


of the above-described well, being first duly sworn on oath, says: That I have knowledge of all
the facts, statements, and matters herein contained and the log of the above-described well
as filed and that the same are true and correct. So help me God.

(Signature) R. Darreel Kelso


CHASE, KANSAS (Address)

SUBSCRIBED AND SWORN TO before me this 20th day of August, 19 80

My commission expires

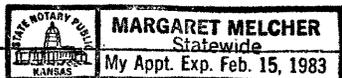

Notary Public.

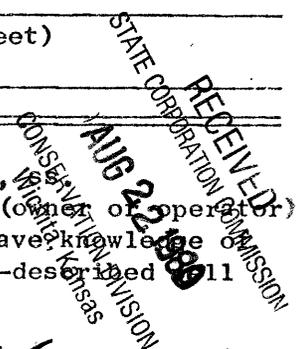

15-147-20030-00-00

DRILLERS LOG

O'Neill No. 2

CASING RECORD: COMPANY: Don H. Peaker, et al DESCRIPTION:

8 5/8" @ 218' CONTRACTOR: Red Tiger Drilling Company NW SW NW

w/160 sx cement COMMENCED: January 30, 1968 23-1S-18W

4 1/2" @ 3623' COMPLETED: February 5, 1968 Phillips Co., K

w/125 sx cement ELEVATION:

TOTAL DEPTH: 3625'

<u>FORMATION</u>	<u>FROM</u>	<u>TO</u>	<u>REMARKS</u>
Surface Clay & Shale	0	220	
Shale	220	1250	
Shale & Sand	1250	1610	
Shale	1610	2160	
Shale & Lime	2160	3045	
Lime	3045	3195	
Lime & Shale	3195	3290	
Lime	3290	3625	

I certify that this is a true and correct copy of the above log to the best of my knowledge.

RED TIGER DRILLING COMPANY

Maxine V. Starr
Maxine V. Starr

Subscribed and sworn to before me this 6th day of February, 1968.

Betty M. Maloney
Notary Public



My Commission Expires:

3-22-71

RECEIVED
STATE CORPORATION COMMISSION

JUL - 7 1980

CONSERVATION DIVISION
Wichita, Kansas