


Give All Information Completely
Make Required Affidavit
Mail or Deliver Report to:
Conservation Division
State Corporation Commission
212 No. Market
Wichita, Kansas

WELL PLUGGING RECORD

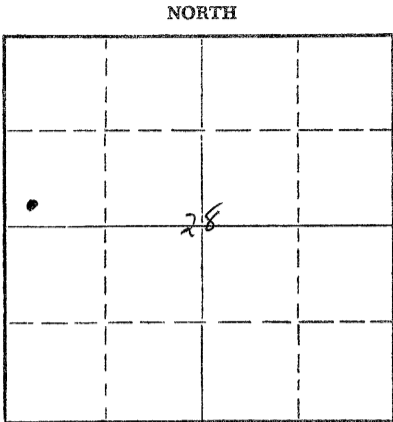

Locate well correctly on above Section Plat

Phillips County, Sec. 28 Twp. 1S Rge. 18W (E) (W)
Location as "NE/CNW/SW" or footage from lines C-SW-SW-NW
Lease Owner Ladd Petroleum Corp.
Lease Name Huffstutter Unit Jackson Well No. C-3
Office Address PO Box 520 Great Bend, Kansas 67530
Character of Well (completed as Oil, Gas or Dry Hole) Oil
Date well completed November 21 1951
Application for plugging filed November 19 1977
Application for plugging approved November 23 1977
Plugging commenced December 22 1977
Plugging completed December 22 1977
Reason for abandonment of well or producing formation Casing bad and junk in hole.

If a producing well is abandoned, date of last production 19
Was permission obtained from the Conservation Division or its agents before plugging was commenced? Yes

Name of Conservation Agent who supervised plugging of this well Leo Massey
Producing formation Lansing Kansas City Depth to top 3410 Bottom 3505 Total Depth of Well 3562' Feet
Show depth and thickness of all water, oil and gas formations.

OIL, GAS OR WATER RECORDS

CASING RECORD

FORMATION	CONTENT	FROM	TO	SIZE	PUT IN	PULLED OUT
Lansing Kansas City	Oil	3410	3505	8 5/8"	256'	None
				5 1/2"	3560'	None

Describe in detail the manner in which the well was plugged, indicating where the mud fluid was placed and the method or methods used in introducing it into the hole. If cement or other plugs were used, state the character of same and depth placed, from feet to feet for each plug set.

Run 2 3/8" Tubing open end to 3431'. Halliburton mixed 35 sx gel and circulated hole thru tubing. Mix 50 sx 50-50 pozmix 2% CC and spot from 3431' to 3065'. Pull 71 jts. tubing and spot 35 sx 50-50 pozmix with 2% CC from 1200' to 945'. Pull 30 jts. tubing and spot 30 sx 50-50 pozmix 2% gel from 300' to 50'. Pulled rest of tubing and filled hole with 20 sx 50-50 pozmix 2% CC.

RECEIVED
STATE CORPORATION COMMISSION

DEC 28 1977

CONSERVATION DIVISION
Wichita, Kansas

(If additional description is necessary, use BACK of this sheet)
Name of Plugging Contractor Ladd Petroleum
Address

STATE OF KANSAS, COUNTY OF Barton, ss.
John Davis (employee of owner) or (owner or operator) of the above-described well, being first duly sworn on oath, says: That I have knowledge of the facts, statements, and matters herein contained and the log of the above-described well as filed and that the same are true and correct. So help me God.

(Signature) John Davis
PO Box 520 Great Bend KS (Address)

SUBSCRIBED AND SWORN TO before me this 23rd day of December, 1977

PHYLLIS C. LOCKWOOD
Barton County, Ks.
My Appt. Exp. 12-5

My commission expires

Phyllis C. Lockwood
Notary Public.