


Give All Information Completely  
Make Required Affidavit  
Mail or Deliver Report to:  
Conservation Division  
State Corporation Commission  
211 No. Broadway  
Wichita, Kansas

15-147-00946-00-00  
WELL PLUGGING RECORD

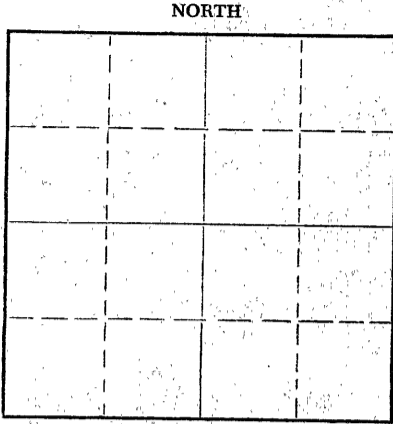

Locate well correctly on above  
Section Plat

Phillips County, Sec. 28 Twp. 1S Rge. 17 (E) W (W)  
Location as "NE/CNW/SW" or footage from lines NW NW NW  
Lease Owner Bulldog. Pipe & Supply Company  
Lease Name Booker Well No. 1  
Office Address P.O. Box 1153 Tulsa, Oklahoma  
Character of Well (completed as Oil, Gas or Dry Hole) Oil  
Date well completed 9 - 17 - 56 19  
Application for plugging filed 3 - 20 - 59 19  
Application for plugging approved 3 - 20 - 59 19  
Plugging commenced April 1 19 59  
Plugging completed April 24 19 59  
Reason for abandonment of well or producing formation  
Non commercial

If a producing well is abandoned, date of last production October 1958  
Was permission obtained from the Conservation Division or its agents before plugging was commenced? Yes

Name of Conservation Agent who supervised plugging of this well Eldon Petty  
Producing formation Lansing-Kansas City Depth to top 3489 Bottom 3641 Total Depth of Well 3641 Feet  
Show depth and thickness of all water, oil and gas formations.

OIL, GAS OR WATER RECORDS

CASING RECORD

FORMATION	CONTENT	FROM	TO	SIZE	PUT IN	PULLED OUT
				8 5/8"	198'	None
				5 1/2"	3639	1140

Describe in detail the manner in which the well was plugged, indicating where the mud fluid was placed and the method or methods used in introducing it into the hole. If cement or other plugs were used, state the character of same and depth placed, from \_\_\_\_\_ feet to \_\_\_\_\_ feet for each plug set.

Filled back with rock and dumped 5 sacks of cement. Pull all but 580' of pipe. Pump 25 sacks mud through pipe and spot 20 sacks of cement at 580'. Pull all but 180'. Pump 15 sacks of cement. Pull all of pipe and spot 10 sacks of cement in top for cap.

RECEIVED  
STATE CORPORATION COMMISSION

JUN 22 1959

CONSERVATION DIVISION  
Wichita, Kansas

(If additional description is necessary, use BACK of this sheet)  
Name of Plugging Contractor Bert Self  
Address R. R. #4 Hutchinson, Kansas

STATE OF Kans. COUNTY OF Reno, ss.  
Employee (employee of owner) or (owner or operator) of the above-described

well, being first duly sworn on oath, says: That I have knowledge of the facts, statements, and matters herein contained and the log of the above-described well as filed and that the same are true and correct. So help me God.

(Signature) Bert Self  
R. R. #4, Hutchinson, Kans.  
(Address)

SUBSCRIBED AND SWORN TO before me this 26th day of April, 19 59

My commission expires August 12, 1961

Notary Public.

PLUGGING  
FILE SEC 28 T. 1 R. 12W  
BOOK PAGE 54 LINE 44