


STATE OF KANSAS  
STATE CORPORATION COMMISSION

Give All Information Completely  
Make Required Affidavit  
Mail or Deliver Report to:  
Conservation Division  
State Corporation Commission  
800 Biting Building  
Wichita, Kansas

15-147-00149-00-00  
WELL PLUGGING RECORD

NORTH

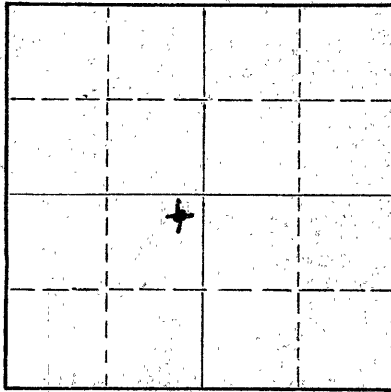

Locate well correctly on above  
Section Plat

Phillips County, Sec. 29 Twp. 1 Rge. 17 (E) (West)  
Location as "NE/CNW/SW" or footage from lines NE NE SW  
Lease Owner Nat'l Associated Petroleum Company  
Lease Name O. R. Baum "A" Well No. 1  
Office Address 502 Ritz Bldg, Tulsa, Oklahoma  
Character of Well (completed as Oil, Gas or Dry Hole) Dry Hole  
Date well completed October 28, 1956 19  
Application for plugging filed October 31, 1956 19  
Application for plugging approved October 28, 1956 (verbal) 19  
Plugging commenced 8:00 A.M. October 28, 1956 19  
Plugging completed 10:00 A.M. October 28, 1956 19  
Reason for abandonment of well or producing formation Dry Hole

If a producing well is abandoned, date of last production \_\_\_\_\_ 19  
Was permission obtained from the Conservation Division or its agents before plugging was commenced? Yes

Name of Conservation Agent who supervised plugging of this well Elden Petty  
Producing formation \_\_\_\_\_ Depth to top \_\_\_\_\_ Bottom \_\_\_\_\_ Total Depth of Well \_\_\_\_\_ Feet  
Show depth and thickness of all water, oil and gas formations.

OIL, GAS OR WATER RECORDS

CASING RECORD

FORMATION	CONTENT	FROM	TO	SIZE	PUT IN	PULLED OUT
Topeka		3320'	3512'	8 5/8"	200'	-0-
Lans. - K. C.		3560'	3716'			

Describe in detail the manner in which the well was plugged, indicating where the mud fluid was placed and the method or methods used in introducing it into the hole. If cement or other plugs were used, state the character of same and depth placed, from \_\_\_\_\_ feet to \_\_\_\_\_ feet for each plug set.

Heavy mud from 3716' to 200'.  
Cement from 200' to 175'.  
Heavy mud from 175' to 10'.  
Cement from 10' to surface.  
Steel cap welded on surface.

RECEIVED  
STATE CORPORATION COMMISSION  
NOV - 1 1956  
CONSERVATION DIVISION  
Wichita, Kansas

(If additional description is necessary, use BACK of this sheet)  
Name of Plugging Contractor Lewis Drilling Company  
Address 607 Union Nat'l Bldg., Wichita, Kansas

STATE OF Kansas, COUNTY OF Phillips, ss.  
Lawrence O. Tenk, Jr. (employee of owner) or (owner or operator) of the above-described well, being first duly sworn on oath, says: That I have knowledge of the facts, statements, and matters herein contained and the log of the above-described well as filed and that the same are true and correct. So help me God.

(Signature) Lawrence O. Tenk, Jr.  
Box 717, McPherson, Kansas  
(Address)

SUBSCRIBED AND SWORN TO before me this 31st day of October, 19 56

My commission expires May 6, 1957

Donna Hunt  
Notary Public.

PLUGGING  
FILE SEC. 29 T. 1 R. 17W  
BOOK PAGE 112 LINE 6

# WELL LOG

15-147-00149-00-00

COMPANY National Associated Petroleum Company

SEC. 29 T1S R17W

FARM Baum "A"

NO. 1

LOC. NE 1/4 NE 1/4 SW 1/4

TOTAL DEPTH 3716'

COMM. 10-20-56


COMP. 10-28-56

COUNTY Phillips  
KANSAS

SHOT OR TREATED

CONTRACTOR Lewis Drilling Company

ISSUED

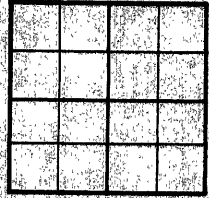

### CASING

20	10
15	8 5/8" - 200'
12	6
13	5

ELEVATION

PRODUCTION

FIGURES INDICATE BOTTOM OF FORMATIONS

0 - 100	Surface Clay and Sand
100 - 800	Shale
800 - 875	Sand
875 - 1550	Sand and Shale
1550 - 1600	Sand
1600 - 1975	Sand and Shale
1975 - 3500	Shale and Lime
3500 - 3716	Lime
3716	T. D.

REC'D  
STATE COMMISSION  
CONSERVATION DIVISION  
Wichita, Kansas

**PLUGGING**  
FILE SEC 29 T 1 R 17W  
BOOK PAGE 112 LINE 6

State of KANSAS

County of SEDGWICK

ss:

I, J. Fred Hambricht of the Lewis Drilling Company

upon oath state that the above and foregoing is a true and correct copy of the log of the Baum "A" #1 well.

Subscribed and sworn to before me this 31st day of October 19 56 (J. Fred Hambricht)

My Commission Expires August 20, 1960

*A. R. Derrington*  
NOTARY PUBLIC

(A. R. Derrington)