

STATE OF KANSAS
STATE CORPORATION COMMISSION


Form CP-4

15-147-20138-00-01
WELL PLUGGING RECORD

Give All Information Completely
Make Required Affidavit
Mail or Deliver Report to:
Conservation Division
State Corporation Commission
P. O. Box 17027
Wichita, Kansas 67217
NORTH

Phillips County, Sec. 3 Twp. 1S Rge. (E) 18 (W)

Location as "NE/CNW4SW4" or footage from lines SW SE SW
Lease Owner Leland R. Baird
Lease Name IMM Well No. 1
Office Address Logan, Kansas 67652
Character of Well (completed as Oil, Gas or Dry Hole) Dry Hole
Date well completed August 28 1975
Application for plugging filed (verbally) August 28 1975
Application for plugging approved (verbally) August 28 1975
Plugging commenced August 28 1975
Plugging completed August 28 1975
Reason for abandonment of well or producing formation No commercial quantities
of oil or gas encountered.

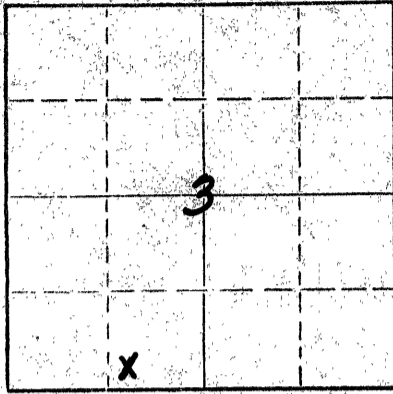

Locate well correctly on above
Section Plat

If a producing well is abandoned, date of last production 19
Was permission obtained from the Conservation Division or its agents before plugging was commenced? Yes

Name of Conservation Agent who supervised plugging of this well Leo Massey
Producing formation _____ Depth to top _____ Bottom _____ Total Depth of Well 3430 Feet
Show depth and thickness of all water, oil and gas formations.

OIL, GAS OR WATER RECORDS

CASING RECORD

FORMATION	CONTENT	FROM	TO	SIZE	PUT IN	PULLED OUT

Describe in detail the manner in which the well was plugged, indicating where the mud fluid was placed and the method or methods used in introducing it into the hole. If cement or other plugs were used, state the character of same and depth placed, from _____ feet to _____ feet for each plug set.

1st Plug Set @ 1050' with 70 sx. cement
2nd Plug Set @ 215' with 20 sx. cement
3rd Plug Set @ 40' with 10 sx. cement

RECEIVED
STATE CORPORATION COMMISSION

SEP 02 1975

CONSERVATION DIVISION
Wichita, Kansas

Name of Plugging Contractor Abercrombie Drilling, Inc.
Address 801 Union Center, Wichita, Kansas 67202

STATE OF KANSAS COUNTY OF SEDGWICK, ss.

(employee of owner) or (owner or operator) of the above-described well, being first duly sworn on oath, says: That I have knowledge of the facts, statements, and matters herein contained and the log of the above-described well as filed and that the same are true and correct. So help me God.

(Signature) Jerry C. Langrehr
801 Union Center, Wichita, Kansas 67202
(Address)

SUBSCRIBED AND SWORN TO before me this 28th day of August, 1975

My commission expires April 8, 1978

Nancy E. Haner Notary Public.

CONTRACTOR'S WELL LOG

OPERATOR: Leland R. Baird
 CONTRACTOR: Abercrombie Drilling, Inc.
 WELL NAME: IMM #1 (washdown)
 LOCATION: SW SE SW Section 3-1S-18W
 Phillips County, Kansas
 SPUD DATE: August 22, 1975
 COMPLETION DATE: August 28, 1975

15-147-20138-00-01

0	1130	Wash through old plugs. (washing down old hole)
1130	1314	Shale (Note: went out of old hole @1130'; Redrilled old hole)
1314	1390	Sand
1390	1674	Shale
1674	1676	Anhydrite
1676	2300	Shale
2300	3029	Lime & Shale
3029	3171	Lime
3171	3284	Lime & Shale
3284	3430	Lime
	3430	Rotary Total Depth

Drig. @1620'. Drilled cement @3:00 p.m. Drilled 1st plug @ 40'; Drilled 2nd Plug @ 250';
 Drilled 3rd Plug @930' to 1064'. Open Hole 1064' to 1095'; Drilled cement 1095' to 1184';
 Open Hole 1184' to 1188'. Started drilling formation (out of hole) @ 1188'.
 Plugged and Abandoned: 1st plug Set @ 1050 w/70 sx. cement; 2nd Plug Set @ 215' w/20 sx. cement;
 3rd Plug Set @ 40' w/10 sx. cement. Plug was down @ 3:30 a.m. August 28, 1975. State Plugger:
 Leo Massey.

ELEVATION:	SAMPLE TOPS:
2051' K.B.	Anhydrite 1674
2049' D.F.	B/Anhydrite 1676
2043' G.L.	

STATE OF KANSAS)
) SS
 COUNTY OF SEDGWICK)

Jerry A. Langrehr, Executive Vice President of Abercrombie Drilling, Inc., does hereby state
 that the above and foregoing is a true and correct copy of the log of the IMM #1 (washdown)
 SW SE SW, Section 3-1S-18W, Phillips County, Kansas.

ABERCROMBIE DRILLING, INC.
 By: *Jerry A. Langrehr*
 Jerry A. Langrehr-Exec. V.P.

Subscribed and sworn to before me, a Notary Public, in and for the aforesaid county and
 state as of this 29th day of August, 1975.

Nancy E. Haner-Notary Public

My Commission Expires: April 8, 1978

RECEIVED
 STATE CONSERVATION COMMISSION
 SEP 02 1975
 CONSERVATION DIVISION
 Wichita, Kansas

