


WELL PLUGGING RECORD

Give All Information Completely  
Make Required Affidavit  
Mail or Deliver Report to:  
Conservation Division  
State Corporation Commission  
211 No. Broadway  
Wichita, Kansas

Phillips County, Sec. 4 Twp. 15 Rge. 18 (W)

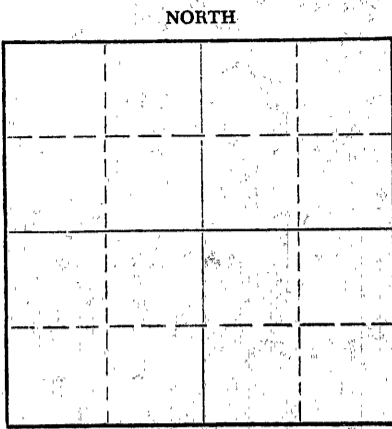

Locate well correctly on above Section Plat

Location as "NE/CNW/SW" or footage from lines \_\_\_\_\_  
Lease Owner C. R. Moffitt  
Lease Name Walker Well No. #1  
Office Address 809 Bitting Bldg. Wichita, Kansas.  
Character of Well (completed as Oil, Gas or Dry Hole) Oil  
Date well completed January 5 1959  
Application for plugging filed March 6 1963  
Application for plugging approved March 7 1963  
Plugging commenced March 17 1963  
Plugging completed March 20 1963  
Reason for abandonment of well or producing formation Decline in production

If a producing well is abandoned, date of last production 10-22 1962  
Was permission obtained from the Conservation Division or its agents before plugging was commenced? yes

Name of Conservation Agent who supervised plugging of this well Eldon Petty  
Producing formation Lansing-K.C. Depth to top 3286 Bottom \_\_\_\_\_ Total Depth of Well 3510 Feet  
Show depth and thickness of all water, oil and gas formations.

OIL, GAS OR WATER RECORDS

CASING RECORD

FORMATION	CONTENT	FROM	TO	SIZE	PUT IN	PULLED OUT
				8 5/8	183'	cemented
				5 1/2	3408'	2723'

Describe in detail the manner in which the well was plugged, indicating where the mud fluid was placed and the method or methods used in introducing it into the hole. If cement or other plugs were used, state the character of same and depth placed, from \_\_\_\_\_ feet to \_\_\_\_\_ feet for each plug set.

Filled with sand from 3445' to 3490, run 4 sacks of cement from 3490' to 3470', shot at 2805', 2706 and started 5 1/2" pipe.

Pumped 11 sacks of jel mud and 20 sacks of cement at 550', pumped 20 sacks of cement at 200' and run 10 sacks of cement from 30' to base of cellar.

RECEIVED  
STATE CORPORATION COMMISSION

MAR 29 1963

CONSERVATION DIVISION  
Wichita, Kansas

(If additional description is necessary, use BACK of this sheet)

Name of Plugging Contractor Glenn & Smith Pipe Pulling Co.  
Address Box 114, Ellinwood, Kansas.

STATE OF Kansas, COUNTY OF Sedgwick, ss.  
C. R. Moffitt (employer or owner) or (owner or operator) of the above-described well, being first duly sworn on oath, says: That I have knowledge of the facts, statements, and matters herein contained and the log of the above-described well as filed and that the same are true and correct. So help me God.

(Signature) C. R. Moffitt  
C. R. Moffitt.  
809 Bitting Bldg. (Address) Wichita, Kansas.

SUBSCRIBED AND SWORN to before me this 28<sup>th</sup> day of March, 1963.

My commission expires August 10, 1965  
Virginia Mundall Notary Public.

C. R. Mcffit - Owner

Sierra Petroleum Co. - Contr:

WALKER #1

NW NW SW Sec. 4-15-18W  
Phillips Count/, Kansas

Total Depth: 3510'

Elevation: 2063 KB

Comm: 12/12/58

Comp: 12/21/58

15-147-19014-00-00

Casings:

8 5/8 @ 183'  
5 1/2 @ 3406

Cement:

with 135 sacks cement  
with 150 sacks cement

FORMATION	DEPTH
Surface Clay	30
Sand & shale	133
Shale & shells	470
Shale	530
Shale & shells	1040
Sand	1070
Shale & shells	1340
Sand	1410
Shale & shells	1620
Shale & red bed	1900
Anhydrite	2015
Shale & shells	2245
Shale, shells & pyrite	2325
Lime & shale	3058
Lime	3125
Lime & shale	3271
Lime	3510
Tops: Heebner	3228
Kansas City	3267

**RECEIVED**  
STATE CORPORATION COMMISSION  
MAR 29 1963  
CONSERVATION DIVISION  
Wichita, Kansas

STATE OF KANSAS )  
                          ) ss:  
COUNTY OF RUSSELL )

I hereby certify that the above information is true and correct  
to the best of my knowledge.

C. R. Mcffit

Subscribed and sworn to before me this 22nd day of December, 1958.

W. H. Cooper  
Notary Public

My commission expires: 1-30-61.