


STATE OF KANSAS
STATE CORPORATION COMMISSION

15-147-00061-00-00
WELL PLUGGING RECORD

Give All Information Completely
Make Required Affidavit
Mail or Deliver Report to:
Conservation Division
State Corporation Commission
800 Bitting Building
Wichita, Kansas

NORTH

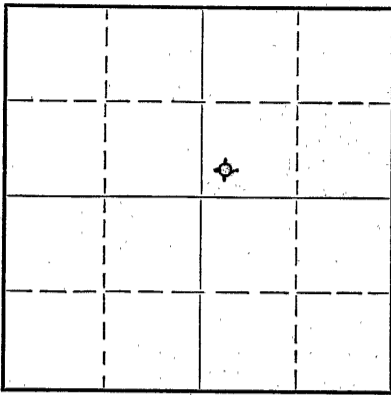

Locate well correctly on above
Section Plat

Phillips County. Sec. 21 Twp. 15 Rge. (E) 16 (W)
Location as "NE/CNW $\frac{1}{4}$ /SW $\frac{1}{4}$ " or footage from lines SW SW NE
Lease Owner Musgrove Petroleum Corporation
Lease Name Jackson Well No. 1
Office Address 407 K F H Building, Wichita, Kansas
Character of Well (completed as Oil, Gas or Dry Hole) Dry Hole
Date well completed 1-26-52 19
Application for plugging filed 1-26-52 19
Application for plugging approved 1-26-52 19
Plugging commenced 6:00 p.m., 1-26-52 19
Plugging completed 8:00 p.m., 1-26-52 19
Reason for abandonment of well or producing formation Commercial quantity of
oil not found.
If a producing well is abandoned, date of last production 19
Was permission obtained from the Conservation Division or its agents before plugging was com-
menced? Yes

Name of Conservation Agent who supervised plugging of this well Eldon Petty, Hays, Kansas
Producing formation Depth to top Bottom Total Depth of Well 3980 Feet
Show depth and thickness of all water, oil and gas formations.

OIL, GAS OR WATER RECORDS

CASING RECORD

Formation	Content	From	To	Size	Put In	Pulled Out
				8 5/8	219	None

Describe in detail the manner in which the well was plugged, indicating where the mud fluid was placed and the method or methods used in introducing it into the hole. If cement or other plugs were used, state the character of same and depth placed, from feet to feet for each plug set.

Filled hole from 3980 to 210 with heavy rotary mud. Set wooden plug.
15 sacks cement to 165'. Filled hole to 40' with rotary mud. Set
second wooden plug. Capped with 10 sacks cement.

(If additional description is necessary, use BACK of this sheet)

Correspondence regarding this well should be addressed to Musgrove Petroleum Corporation
Address 407 K F H Building, Wichita, Kansas

STATE OF KANSAS, COUNTY OF SEDGWICK, ss.
Clinton Engstrand, agent for (employment owner) of the above-described well,
being first duly sworn on oath, says: That I have knowledge of the facts, statements, and matters herein contained and the log of the above-
described well as filed and that the same are true and correct. So help me God

(Signature) *Clinton Engstrand*
1006 Central Building, Wichita, Kansas
(Address)

SUBSCRIBED AND SWORN to before me this 28th day of January 1952

My commission expires 12-19-55

REC Due Pearl
STATE CORPORATION COMMISSION
Notary Public

23-5091-s 8-50-10M
PLUGGING
FILE SEC 21 T 1 R 16
BOOK PAGE 141 OF 17
JAN 29 1952
CONSERVATION DIVISION
Wichita, Kansas

MUSGROVE PETROLEUM CORPORATION
JACKSON #1

15-47-00061-00-00

SW SW NE Section 21-18-16W
Phillips County, Kansas

Comm: 1-15-52
Comp: 1-26-52
Total Depth: 3980'

<u>Casing</u>	<u>Cement</u>
3 5/8" Set @ 219	150 Sacks
5 1/2" - None	

<u>FORMATION</u>	<u>DEPTH</u>
Surface clay & sand	0 - 219
Blue shale	219 - 1031
Sand	1031 - 1060
Shale & shells	1060 - 1252
Shale, shells & sand	1252 - 1648
Anhydrite	1648 - 1665
Shale & shells	1665 - 1892
Lime & shale	1892 - 2538
Shale & shells	2538 - 2610
Lime & shale	2610 - 3940
Chert	3940 - 3960
Lime & shale	3960 - 3980
Arbuckle	3980

STATE OF KANSAS)
) SS
 SEDGWICK COUNTY)

I hereby certify that the above information is true and correct to the best of my knowledge.

[Handwritten Signature]

Subscribed and sworn to before me this 28th day of January, 1952.

[Handwritten Signature]
Notary Public

My commission expires: 12-19-55

PLUGGING
 FILE NO. 21-18-16W
 PAGE 146 (1952)

JAN 28 1952