


STATE OF KANSAS
STATE CORPORATION COMMISSION

Give All Information Completely
Make Required Affidavit
Mail or Deliver Report to:
Conservation Division
State Corporation Commission
800 Bitting Building
Wichita, Kansas

15-147-30169-00-00
WELL PLUGGING RECORD

NORTH

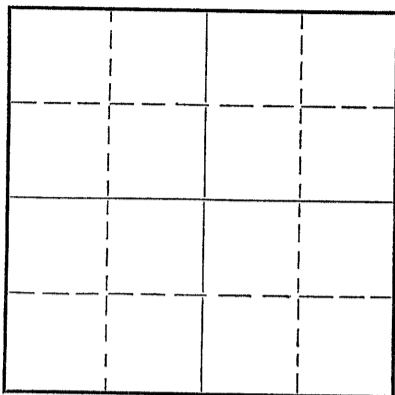

Locate well correctly on above
Section Plat

Phillips County, Sec. 2 Twp 18 Rge 18 (E) (W)
Location as "NE/CNW $\frac{1}{4}$ SW $\frac{1}{4}$ " or footage from lines NE/C NE/4 NW/4
Lease Owner L. B. Stableford
Lease Name Caswell Well No. 1
Office Address 333 N. Michigan Avenue, Chicago, Illinois
Character of Well (completed as Oil, Gas or Dry Hole) Dry Hole
Date well completed December 1, 19 50
Application for plugging filed " 1, 19 W
Application for plugging approved " 1, 19 W
Plugging commenced 11:00 A.M. " 1, 19 W
Plugging completed 1:00 P.M. " 1, 19 W
Reason for abandonment of well or producing formation Commercial quantity
of oil not found.
If a producing well is abandoned, date of last production 19
Was permission obtained from the Conservation Division or its agents before plugging was com-
menced? Yes

Name of Conservation Agent who supervised plugging of this well Stough
Producing formation Depth to top Bottom Total Depth of Well 3505 Feet
Show depth and thickness of all water, oil and gas formations.

OIL, GAS OR WATER RECORDS

CASING RECORD

Formation	Content	From	To	Size	Put In	Pulled Out
				8 5/8	116'	None

Describe in detail the manner in which the well was plugged, indicating where the mud fluid was placed and the method or methods used in introducing it into the hole. If cement or other plugs were used, state the character of same and depth placed, from feet to feet for each plug set.

Gunned pits and loaded hole with heavy mud. Pushed a 4' wooden plug to bottom of surface pipe, 114 feet. Then placed 50 lbs. of cotton seed hulls on top of wooden plug. Then spotted 15 sacks of cement on top of hulls. Filled surface pipe with heavy mud to 30'. Pushed a second 4' wooden plug to top of mud. Then placed 50 lbs. of cotton seed hulls on top of plug and capped with 5 sacks of cement.

RECEIVED
STATE CORPORATION COMMISSION
DEC 9 - 1950
CONSERVATION DIVISION
Wichita, Kansas

(If additional description is necessary, use BACK of this sheet)

Correspondence regarding this well should be addressed to L. B. Stableford
Address 333 N. Michigan Avenue, Chicago, Illinois

STATE OF KANSAS, COUNTY OF SEDGWICK, ss.
Clinton Engstrand, Agent for

(Employee of owner) or (owner or operator) of the above-described well, being first duly sworn on oath, says: That I have knowledge of the facts, statements, and matters herein contained and the log of the above-described well as filed and that the same are true and correct. So help me God.

(Signature) *Clinton Engstrand*
612 Union Nat'l. Bk. Bldg., Wichita
(Address)

SUBSCRIBED AND SWORN to before me this 8th day of December, 19 50

My commission expires 6-5-54

J. P. Anderson
Notary Public.

28-3278-s 4-50-10M

PLUGGING
FILE SEC 21-1 R/L/W
BOOK PAGE 47 LINE 3

L. B. STARLEFORD
CASWELL # 1

15-147-30169-00-00
NE NE NW Sec. 2 Twp. 13 Rge. 18W
Phillips County, Kansas

Total Depth: 3505'
Comm: 11/20/50
Comp: 12/1/50

Casing
8 5/8" Set @ 118'
5 1/2"

Cement
100 Sacks
None

Formation	Depth
Sand shale	0 - 70
Shale & sand	70 - 118
Shale & shells	118 - 700
Sand	700 - 800
Shale & shells	800 - 1050
Shale shells	1050 - 1715
Shale & shells	1715 - 1730
Anhydrite	1730 - 1760
Red bed, shale & shells	1760 - 1815
Shale shells	1815 - 2080
Shale & shells	2080 - 2240
Shale & lime	2240 - 2305
Shale shells	2305 - 2410
Shale & lime	2410 - 2515
Lime & shale streaks, chertie	2515 - 2600
Shale lime	2600 - 2645
Lime & shale	2645 - 2810
Lime shale	2810 - 2875
Shale & lime	2875 - 2990
Lime	2990 - 3060
Lime & shale	3060 - 3199
Lime	3199 - 3505
Total Depth 3505	

STATE OF KANSAS }
SEDGWICK COUNTY } SS

I hereby certify that the above information is true and correct to the best of my knowledge.

[Signature]

Subscribed and sworn to before me this 8th day of December, 1950.

[Signature]
Notary Public

My commission expires: 6-5-54

PLUGGING
FILE SEC 2 12 1180
BOOK PAGE 47 LINE 2

RECEIVED
STATE CORPORATION COMMISSION
DEC 9 - 1950
CONSERVATION DIVISION
Wichita, Kansas