


WELL PLUGGING RECORD

Give All Information Completely
Make Required Affidavit
Mail or Deliver Report to:
Conservation Division
State Corporation Commission
800 Bitting Building
Wichita, Kansas

Phillips County, Sec. 3, Twp. 1 S Rge. 18 W (E) (W)

Location as "NE/CNW/SW" or footage from line NE NE NW
Lease Owner Buick Drilling Inc. and Simmons
Lease Name Furse Well No. 1
Office Address 409 Wolcott Bldg. Hutchinson, Kansas
Character of Well (completed as Oil, Gas or Dry Hole) Dry Hole
Date well completed March 21 1961
Application for plugging filed March 22 1961
Application for plugging approved (verbal) March 21 1961
Plugging commenced March 21 1961
Plugging completed March 21 1961
Reason for abandonment of well or producing formation _____

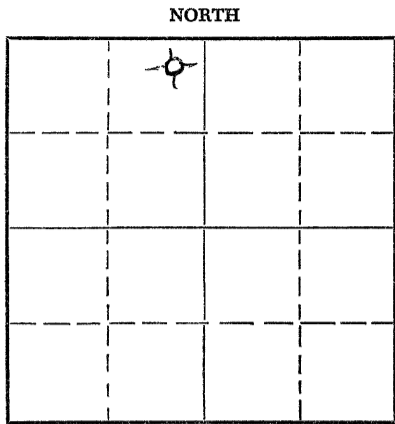

Locate well correctly on above Section Plat

If a producing well is abandoned, date of last production _____ 19____
Was permission obtained from the Conservation Division or its agents before plugging was commenced? Yes

Name of Conservation Agent who supervised plugging of this well Eldon Petty
Producing formation _____ Depth to top _____ Bottom _____ Total Depth of Well 3500 Feet
Show depth and thickness of all water, oil and gas formations.

OIL, GAS OR WATER RECORDS

CASING RECORD

FORMATION	CONTENT	FROM	TO	SIZE	PUT IN	PULLED OUT
				8 5/8"	165	None

Describe in detail the manner in which the well was plugged, indicating where the mud fluid was placed and the method or methods used in introducing it into the hole. If cement or other plugs were used, state the character of same and depth placed, from _____ feet to _____ feet for each plug set.

Plug at 500' with 20 sacks of cement; Plug at 160 Feet with 15 Sacks cement; Plug at 35' with 10 Sacks cement; Filled hole between plugs with heavy rotary mud.

RECEIVED
STATE CORPORATION COMMISSION
MAR 28 1961
CONSERVATION DIVISION
Wichita, Kansas

(If additional description is necessary, use BACK of this sheet)
Name of Plugging Contractor Buick Drilling Inc.
Address 409 Wolcott Bldg., Hutchinson, Kansas

STATE OF Kansas, COUNTY OF Reno, ss.
H. R. Buick - President (employee of owner) or (owner or operator) of the above-described well, being first duly sworn on oath, says: That I have knowledge of the facts, statements, and matters herein contained and the log of the above-described well as filed and that the same are true and correct. So help me God.

(Signature) H. R. Buick
H. R. Buick, Pres. Buick Drilling Inc.
409 Wolcott Bldg., Hutchinson, Kansas (Address)

SUBSCRIBED AND SWORN TO before me this 22nd day of March, 1961

My commission expires Nov. 16, 1961
Wilma A. Clark
Wilma A. Clark Notary Public.

WELL LOG

15-14719 012-00-00

WELL #1 NE/4 NE/4 NW/4 Sec. 3-18-18W
Phillips County, Kansas

COMPANY Buick Drilling Inc. & Simmons

CONTRACTOR Buick Drilling Inc.

COMMENCED March 12, 1961

COMPLETED March 21, 1961

CASING 165' of 8 5/8" cemented
with 130 Sacks

ELEVATION

DEPTH	FORMATION
0 to 165	Sand and Shale
165 to 195	Shale and Shells
195 to 900	Shale
900 to 1160	Shale and Shells
1160 to 1270	Shale
1270 to 2255	Shale and Lime
2255 to 3500 T. D.	Lime
Dry and Abandoned	

I, H. R. Buick, certify that this is a true and correct copy of the log of the above well, according to the records of this office.

H. R. Buick Pres.
Buick Drilling Inc.

Subscribed and sworn to before me, a Notary Public, this 22nd day of March, 1961.

My Commission Expires Nov. 16, 1961 *Wilma A. Clark*
Wilma A. Clark, Notary Public

RECEIVED
STATE CORPORATION COMMISSION
MAR 28 1961
CONSERVATION DIVISION
Wichita, Kansas