


STATE OF KANSAS  
STATE CORPORATION COMMISSION

15-147-30186-00-00  
WELL PLUGGING RECORD

Give All Information Completely  
Make Required Affidavit  
Mail or Deliver Report to:  
Conservation Division  
State Corporation Commission  
800 Bitting Building  
Wichita, Kansas

Phillips County, Sec. 7 Twp. 1S Rge. 18 (E) (W)

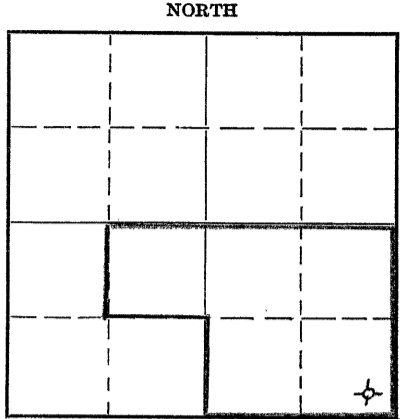

Locate well correctly on above Section Plat

Location as "NE/CNW $\frac{1}{4}$ SW $\frac{1}{4}$ " or footage from lines SE SE SE  
Lease Owner Black Cat Oil Company  
Lease Name Bjurstrom Well No. 1  
Office Address Box 62, Great Bend, Kansas  
Character of Well (completed as Oil, Gas or Dry Hole) Dry  
Date well completed April 19, 19 51  
Application for plugging filed April 23, 19 51  
Application for plugging approved April 25, 19 51  
Plugging commenced May 3, 19 51  
Plugging completed May 9, 19 51  
Reason for abandonment of well or producing formation Dry

If a producing well is abandoned, date of last production 19...  
Was permission obtained from the Conservation Division or its agents before plugging was commenced? Yes

Name of Conservation Agent who supervised plugging of this well Elden Petty  
Producing formation - - - - - Depth to top - - - - - Bottom - - - - - Total Depth of Well 3728' Feet  
Show depth and thickness of all water, oil and gas formations.

OIL, GAS OR WATER RECORDS

CASING RECORD

Formation	Content	From	To	Size	Put In	Pulled Out
				8 5/8"	160'	cemented
				5 1/2"	3442"	2886'

Describe in detail the manner in which the well was plugged, indicating where the mud fluid was placed and the method or methods used in introducing it into the hole. If cement or other plugs were used, state the character of same and depth placed, from 3728' feet to 0 feet for each plug set.

Filled hole to 3325' with sand, dumped 4 sacks of cement, at 3325', with dump bailor.  
Shot off and pulled 2886' of 5 1/2" pipe.  
Mudded hole to 155'. Set 15' rock bridge at 155'. Dumped 15 sacks of cement at 140'.  
Mudded hole to 30'. Set 10' rock Bridge at 30'. Dumped 10' sacks of cement to fill surface pipe to bottom of cellar.

RECEIVED  
STATE CORPORATION COMMISSION  
JUN 28 1951  
CONSERVATION DIVISION  
Wichita, Kansas

(If additional description is necessary, use BACK of this sheet)

Correspondence regarding this well should be addressed to Black Cat Oil Company  
Address Box 62, Great Bend, Kansas

STATE OF KANSAS COUNTY OF BARTON, ss.  
Leon F. Huff, Partner of (Employee of owner) or (owner or operator) of the above-described well,  
being first duly sworn on oath, says: That I have knowledge of the facts, statements, and matters herein contained and the log of the above-described well as filed and that the same are true and correct. So help me God.  
(Signature) Leon F. Huff  
Box 62, Great Bend, Kansas (Address)

SUBSCRIBED AND SWORN to before me this 21st day of May 19 51

My commission expires April 4, 1955 Peggy L. Shank Notary Public.

PLUGGING  
FILE REC-71-LR-16W  
BOOK PAGE 77 LINE 24

15-147-30186-00-00

DRILLER'S LOG

OPERATOR: Black Cat Oil Company Location: SE SE Section 7-10-18W  
 WELL NAME: Bjurestrom Phillips County, Kansas  
 WELL NUMBER: #1  
 CONTRACTOR: Black Cat Oil Company CASING RECORD: 8-5/8" @ 160', cemented  
 w/125 sacks cement and  
 1 sack calcium chloride  
 ROTARY COMMENCED: April 2, 1951 5-1/2" @ 3442', cemented  
 ROTARY COMPLETED: April 14, 1951 w/100 sacks cement.  
 ELEVATION: 2067' Rotary Bushing Initial Production:

Figures denote bottom of formation

Shale and Shells	300
Shale, Shells and Sand	785
Shale and Shells	1,025
Sand, Shale and Shells	1,285
Shale and Shells	1,675
Anhydrite	1,700
Shale and lime	1,905
Shale	2,000
Brown lime	2,225
Lime	2,350
Shale and Shells	2,515
lime	2,605
Lime and Shale	2,790
Bro Lime	2,840
Lime and Shale	2,965
Lime	3,023
lime and shale	3,090
Lime	3,155
Shale and lime	3,230
Lime	3,300
Bro Lime	3,370
lime	3,523
Lime, Chert and Shale	3,690
Conglomerate and Arbuckle Cherty	3,728

Rotary Total Depth

CERTIFICATE

STATE OF KANSAS )  
 ) ss  
 BARTON COUNTY )

I hereby certify that the foregoing is, to the best of my knowledge and belief, a full, true and correct drilling log as shown by the daily drilling reports in connection with the afore said well.

*Leon P. Huff*  
 Leon P. Huff  
 Partner of Black Cat Oil Company

Subscribed and sworn to before me, the undersigned, a Notary Public, this 20th day of April, 1951

RECEIVED  
 PLUGGING  
 FILE # 7-1 APR 25 1951  
 BOOK PAGE 271 DIVISION  
 Wichita, Kansas  
 My commission expires March 6, 1954.

*Mildred Hobbie*  
 Mildred Hobbie  
 Notary Public