


WELL PLUGGING RECORD

Give All Information Completely
Make Required Affidavit
Mail or Deliver Report to:
Conservation Division
State Corporation Commission
800 Biting Building
Wichita, Kansas

NORTH

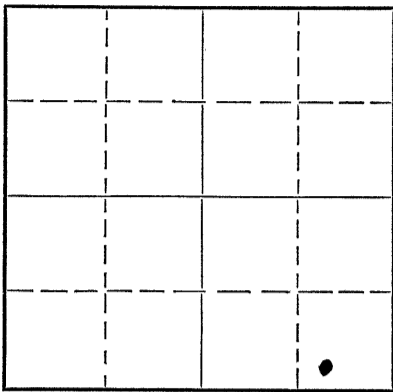

Locate well correctly on above
Section Plat

Phillips County. Sec. 7 Twp. 1 Rge. 18 (E) W (W)
Location as "NE/CNW $\frac{1}{4}$ SW $\frac{1}{4}$ " or footage from lines SW SE SE SW
Lease Owner Honaker Drilling Co., Inc., et al
Lease Name Hector Well No. 1
Office Address Great Bend, Kansas
Character of Well (completed as Oil, Gas or Dry Hole) Dry
Date well completed April 13, 19 51
Application for plugging filed April 13, 19 51
Application for plugging approved April 13, 19 51
Plugging commenced April 14, 19 51
Plugging completed April 20, 19 51
Reason for abandonment of well or producing formation Dry

If a producing well is abandoned, date of last production 19
Was permission obtained from the Conservation Division or its agents before plugging was commenced? Yes

Name of Conservation Agent who supervised plugging of this well Eldon Petty
Producing formation Depth to top Bottom Total Depth of Well 3490 Feet
Show depth and thickness of all water, oil and gas formations.

OIL, GAS OR WATER RECORDS

CASING RECORD

| Formation | Content | From | To | Size | Put In | Pulled Out |
|-----------|---------|------|----|-----------------|--------|------------|
| | | | | 5 $\frac{1}{2}$ | 3523 | 2511 |
| | | | | | | |
| | | | | | | |
Describe in detail the manner in which the well was plugged, indicating where the mud fluid was placed and the method or methods used in introducing it into the hole. If cement or other plugs were used, state the character of same and depth placed, from feet to feet for each plug set.
Mudded hole to 140', set 10' rock bridge at 140', dumped 15 sacks cement at 125', mudded hole to 30', set 10' rock bridge at 30' and dumped 10 sacks cement filling hole to top.

RECEIVED
STATE CORPORATION COMMISSION
APR 27 1951
CONSERVATION DIVISION
Wichita, Kansas

(If additional description is necessary, use BACK of this sheet)
Correspondence regarding this well should be addressed to Honaker Drilling Co., Inc.
Address Great Bend, Kansas

STATE OF Kansas, COUNTY OF Barton, ss.
Joe J. Honaker (employee of owner) or (owner or operator) of the above-described well,
being first duly sworn on oath, says: That I have knowledge of the facts, statements, and matters herein contained and the log of the above-described well as filed and that the same are true and correct. So help me God.

(Signature) Joe J. Honaker
Great Bend, Kansas
(Address)

SUBSCRIBED AND SWORN to before me this 25th day of April, 19 51
L. L. Lanaway
Notary Public.

PLUGGING
FILE SEC 7 T 1 R 18 W
BOOK PAGE 68 LINE 22

WELLERS LOG

Operator: Honaker Drilling Co., Inc.

Contractor: Honaker Drilling Co., Inc.

Lease: Hector #1

15-147-00078-00-00

| | From | To |
|--------------|------|-----|
| Shale & Rock | 0 | 50 |
| Shale | 50 | 140 |

Run 141.93' of 5-5/8" new casing, set @ 140', cemented with 125 sacks cement & 200# CaCl

| | | |
|-----------------|------|------------|
| Shale | 140 | 250 |
| Sand & Shale | 250 | 890 |
| Sand | 890 | 1015 |
| Shale & Sand | 1015 | 1178 |
| Shale | 1178 | 1250 |
| Sand | 1250 | 1385 |
| Shale & Shells | 1385 | 1640 |
| Shale & Red Bed | 1640 | 1755 |
| Anhydrite | 1755 | 1784 |
| Red Bed & Shale | 1784 | 1870 |
| Shale | 1870 | 1939 |
| Lime & Shale | 1939 | 3298 |
| Lime | 3298 | 3490 T. D. |

Company Time With Drill Pipes:

| | | |
|--------|------------|---------|
| 1-5-51 | Circulated | 30 min. |
| 1-6-51 | do | 2 hrs. |

Run 111 jts 5 1/2" OD casing, 3523.56', cemented with 175 sacks cement.

The foregoing is correct to the best of my knowledge.

HONAKER DRILLING CO., INC.

By _____

STATE CORP.
 MAR 2 1951
 CONSERVATION
 Wichita, Kansas

PLUGGING

FILE SEC 7 T 1 R 190
 BOOK PAGE 68 LINE 22