


Give All Information Completely
Make Required Affidavit
Mail or Deliver Report to:
Conservation Division
State Corporation Commission
800 Bittling Building
Wichita, Kansas

15-147-00073-00-00

WELL PLUGGING RECORD

Phillips County, Sec 9 Twp 1S Rge 18 (E) (W)

Location as "NE/CNW $\frac{1}{4}$ /SW $\frac{1}{4}$ " or footage from lines SW SW SW
Lease Owner Black Cat Oil Company
Lease Name Seyler Well No. #1
Office Address Box 62, Great Bend, Kansas
Character of Well (completed as Oil, Gas or Dry Hole) Dry Hole
Date well completed April 1, 19 51
Application for plugging filed April 1, 19 51
Application for plugging approved April 4, 19 51
Plugging commenced April 1, 19 51
Plugging completed April 1, 19 51
Reason for abandonment of well or producing formation Dry Hole

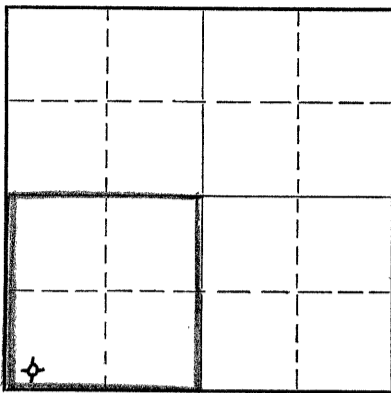

Locate well correctly on above Section Plat

If a producing well is abandoned, date of last production - - - - - 19 - -
Was permission obtained from the Conservation Division or its agents before plugging was commenced? Yes

Name of Conservation Agent who supervised plugging of this well Mr. Eldon Petty
Producing formation - - - - - Depth to top - - - - - Bottom - - - - - Total Depth of Well 3580 Feet
Show depth and thickness of all water, oil and gas formations.

OIL, GAS OR WATER RECORDS

CASING RECORD

Formation	Content	From	To	Size	Put In	Pulled Out
				8-5/8"	200'	- - -

Describe in detail the manner in which the well was plugged, indicating where the mud fluid was placed and the method or methods used in introducing it into the hole. If cement or other plugs were used, state the character of same and depth placed, from 3580 feet to 0 feet for each plug set.

Filled hole with heavy mud up to 200'; set plug @ 195'; cemented with 15 sacks cement; set top plug @ 40' @ cemented with 10 sacks of cement.

(If additional description is necessary, use BACK of this sheet)

Correspondence regarding this well should be addressed to Black Cat Oil Company
Address Box 62, Great Bend, Kansas

STATE OF KANSAS, COUNTY OF BARTON, ss.
Leon F. Huff, Partner (employee or owner) Sr (owner or operator) of the above-described well,

being first duly sworn on oath, says: That I have knowledge of the facts, statements, and matters herein contained and the log of the above-described well as filed and that the same are true and correct. So help me God.

(Signature) Leon F. Huff
Box 62, Great Bend, Kansas (Address)

SUBSCRIBED AND SWORN to before me this 6th day of April 19 51

March 6, 1954

RECEIVED
STATE CORPORATION COMMISSION
Notary Public.

APR - 7 1951

CONSERVATION DIVISION
Wichita, Kansas

PLUGGING
FILE SEC 9 T L R 18 W
BOOK PAGE 71 LINE 15

DRIILING TIME LOG

19-147-00073-00-00

Black Cat Oil Company
27 3/4 SW
Section 9-13-18
Phillips County Kansas

Boyer #1

Size Hole: 7-7/8"

Drill Pipe: 4-1/2"

Depth		Minutes	Remarks
From	To		
2850	2860	7-6-6-4-3-4-5-5-5-5	
2860	2870	5-5-5-7-6-7-5-5-5-5	
2870	2880	4-4-4-6-6-7-6-7-7-2	Conn. 14 min. @ 2872
2880	2890	4-6-7-6-7-5-5-7-5-7	
2890	2900	6-7-5-6-4-3-2-1-1-2	
2900	2910	2-3-2-2-4-3-4-4-4-4	Conn. 7 min. @ 2903
2910	2920	5-4-5-7-5-5-2-2-3-6	
2920	2930	9-8-8-9-6-7-5-5-4-4	
2930	2940	4-4-4-6-6-6-5-5-7-8	Conn. 6 min. @ 2931
2940	2950	9-6-7-4-4-7-7-10-8-8	
2950	2960	8-6-8-8-9-10-9-5-4	
2960	2970	8-4-7-10-7-7-8-8-7-6	Conn. 5 min. @ 2962
2970	2980	4-5-6-3-2-2-1-3-6-2	
2980	2990	7-9-3-5-7-6-4-5-5-7	
2990	3000	6-7-9-10-10-10-7-6-7-8	Conn. 9 min. @ 2992 Trip 7:15 @ 2995
3000	3010	7-5-4-3-4-4-3-3-2-3	
3010	3020	5-4-3-6-6-7-7-9-7-5	
3020	3030	8-4-5-8-5-4-5-4-3-5	Conn. 16 min. @ 3020
3030	3040	5-5-8-8-5-4-5-6-6-7	
3040	3050	6-6-5-5-5-6-3-3-5-4	
3050	3060	4-7-4-5-4-4-8-3-2-3	Conn. 7 min. @ 3050
3060	3070	5-4-5-4-5-4-4-4-4-3	
3070	3080	4-4-4-6-6-6-6-7-7-7	
3080	3090	6-6-6-6-5-6-7-5-4-1	Conn. 6 min. @ 3080 Cleaning pit 44 min. @ 3087
3090	3100	3-4-3-3-6-4-5-5-6-4	
3100	3110	7-5-8-5-3-4-3-4-3-3	
3110	3120	8-6-8-7-7-8-8-9-10-10	Conn. 11.6 min. @ 3110
3120	3130	3-2-3-3-2-2-4-3-3-6	
3130	3140	4-3-4-3-3-5-4-3-5-2	Conn. 5 min. @ 3140
3140	3150	6-5-6-8-9-10-9-10-11-12	
3150	3160	8-4-4-6-4-4-4-4-5-9	
3160	3170	10-10-9-9-8-8-10-9-7-6	
3170	3180	7-9-5-3-2-4-3-6-5-5	Conn. 6 min. @ 3170
3180	3190	3-3-3-3-3-1-1-1-1-1	
3190	3200	2-2-2-3-3-6-7-8-6-6	Gir. 1hr. @ 3197 Conn. 6 min. @ 3201
3200	3210	5-6-6-7-4-4-7-9-9-10	
3210	3220	9-10-8-9-7-9-9-9-7-7	
3220	3230	9-7-8-9-8-11-10-11-12-12	
3230	3240	12-10-7-7-5-6-6-6-4-3	Trip 5:22 @ 3231 44 min. @ 3246 working on cellar pit.
3240	3250	6-5-3-6-6-6-5-5-5-4	
3250	3260	5-5-7-7-6-3-3-3-3-4	
3260	3270	6-6-8-7-8-9-10-7-8-9	Conn. 6 min. @ 3260
3270	3280	9-8-9-8-8-8-7-5-2-2	
3280	3290	4-10-10-6-4-6-8-6-7-7	
3290	3300	5-5-6-6-6-6-7-7-5-8	Conn. 6 min. @ 3291
3300	3310	6-6-7-6-4-5-5-5-5-5	
3310	3320	5-7-9-7-8-7-6-5-6-6	
3320	3330	5-7-6-6-6-7-5-7-6-9	Conn. 7 min. @ 3322
3330	3340	8-9-9-9-8-9-9-8-9-9	
3340	3350	8-9-8-8-9-8-10-8-8-10	
3350	3360	8-7-8-6-7-7-7-8-8-7	Conn. 6 min. @ 3352

PLUGGING
 FILE SEC 9-T-1-186
 BOOK PAGE 71 LINE 15

FIVED
 APR - 7 1951
 DIVISION
 Wichita, Kansas

Drilling Report
 Seyler #1
 Black Cat Oil Company

Depth		Minutes	Remarks
From	To		
3360	3370	4-6-5-5-5-6-6-6-7-9	Cir. 1 Hr. @ 3360 Cir. 1 Hr. @ 3368
3370	3380	8-7-8-9-8-8-7-8-6-5	
3380	3390	5-5-5-9-10-9-10-10-9-11	2 mins. difference in watch
3390	3400	8-11-9-13-10-9-11-7-7-10	Cir. 1 Hr. @ 3395
3400	3410	10-10-11-9-8-10-10-10-12-11	
3410	3420	11-9-8-7-6-7-6-8-10-9	Conn. 7 min. @ 3413
3420	3430	11-11-12-11-8-5-5-6-5-5	Trip: 2:48 @ 3425
3430	3440	7-5-5-6-5-8-5-5-2-6	
3440	3450	6-6-7-6-7-4-4-4-4-5	Conn. 7 min. @ 3443
3450	3460	5-5-9-5-8-8-7-8-7-12	
3460	3470	8-8-9-8-8-9-8-6-3-8	
3470	3480	6-8-6-6-7-8-6-7-7-8	
3480	3490	10-10-10-5-7-8-8-7-6-6	
3490	3500	8-11-10-10-10-10-9-8-7-8	
3500	3510	7-6-6-8-7-7-7-7-7-7	Conn. 8 min. @ 3504
3510	3520	8-7-9-7-6-8-8-7-6-6	
3520	3530	5-7-6-6-8-10-7-9-9-11	
3530	3540	9-9-7-6-6-7-7-6-7-9	Conn. 6 min. @ 3534
3540	3550	8-7-8-7-8-8-7-7-6-4	
3550	3560	5-1-8-1-1-2-3-4-4-5	
3560	3570	6-7-7-7-7-10-10-10-9-10	
3570	3580	8-7-9-8-8-7-8-6-8-7	

RECEIVED
 REGISTRATION COMMISSION
 APR 7 1951
 CONSERVATION DIVISION
 Wichita, Kansas