


STATE OF KANSAS
STATE CORPORATION COMMISSION

15-147-00648-00-00
WELL PLUGGING RECORD

Give All Information Completely
Make Required Affidavit
Mail or Deliver Report to:
Conservation Division
State Corporation Commission
800 Bittling Building
Wichita, Kansas

NORTH

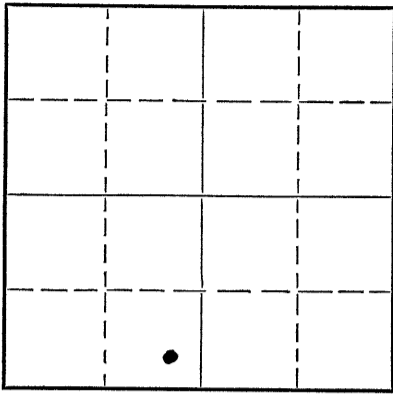

Locate well correctly on above
Section Plat

Phillips County. Sec. 6 Twp. 1S Rge. 18 (E) W (W)
Location as "NE/CNW $\frac{1}{4}$ SW $\frac{1}{4}$ " or footage from lines SE SE SW
Lease Owner Honaker Drilling Co., Inc., et al
Lease Name Farley Well No. 1
Office Address Great Bend, Kansas
Character of Well (completed as Oil, Gas or Dry Hole) Dry Hole
Date well completed March 26, 19 51
Application for plugging filed April 17, 19 51
Application for plugging approved April 20, 19 51
Plugging commenced April 25, 19 51
Plugging completed April 30, 19 51
Reason for abandonment of well or producing formation Dry

If a producing well is abandoned, date of last production 19
Was permission obtained from the Conservation Division or its agents before plugging was commenced? Yes

Name of Conservation Agent who supervised plugging of this well Eldon Petty
Producing formation Depth to top Bottom Total Depth of Well 3410 Feet
Show depth and thickness of all water, oil and gas formations.

OIL, GAS OR WATER RECORDS

CASING RECORD

Formation	Content	From	To	Size	Put In	Pulled Out
				8-5/8	223	None
				5 $\frac{1}{2}$	3409	2422

Describe in detail the manner in which the well was plugged, indicating where the mud fluid was placed and the method or methods used in introducing it into the hole. If cement or other plugs were used, state the character of same and depth placed, from feet to feet for each plug set.

Set plug and dumped 5 sacks cement at 3284'. Filled with heavy mud to 223', set plug and dumped 15 sacks cement; then filled with heavy mud to 15 feet and set plug and dumped 5 sacks cement.

RECEIVED
STATE CORPORATION COMMISSION
MAY 1 - 1951
CONSERVATION DIVISION
Wichita, Kansas

(If additional description is necessary, use BACK of this sheet)

Correspondence regarding this well should be addressed to Honaker Drilling Co., Inc.
Address Great Bend, Kansas

STATE OF Kansas, COUNTY OF Barton, ss.
E. O. Squires (employee of owner) or (owner or operator) of the above-described well,
being first duly sworn on oath, says: That I have knowledge of the facts, statements, and matters herein contained and the log of the above-described well as filed and that the same are true and correct. So help me God.

(Signature) *E. O. Squires*
Great Bend, Kansas
(Address)

SUBSCRIBED AND SWORN to before me this 30th day of April, 19 51

L. E. Caraway
Notary Public.

My commission expires 9-1-54

PLUGGING
FILE SEC 6 T 1 R 18 W
BOOK PAGE 74 LINE 15

DRILLERS LOG

15-147-00648-00-00

Elev. 2035 DF

Operator: Honaker Drilling Co., Inc.
 Lease: Farley #1
 Contractor: Honaker Drilling Co., Inc.

	From	To
Shale & Shells	0	120
Shale & Shells	120	224

Run 223.27' (12 joints) 8-5/8" surface casing, cemented with 150 sacks cement and 300# CaCl.

Shale & Shells	224	1100	
Sand & Shale	1100	1280	
Flint Rock	1280	1310	
Shale & Shells	1310	1800	
Anhydrite	1800	1845	
Shale & Shells	1845	2050	
Shale & Lime	2050	3105	
Broken Lime	3105	3185	
Lime	3185	3410	T. D.

Run 112 joints 5 1/2" 14# used casing, set at 3408' with 175 sacks cement.

The foregoing is correct to the best of my knowledge.

HONAKER DRILLING CO., INC.

BY: _____
 President

PLUGGING RECEIVED
 FILE SEC 6 T L R 125 CORPORATION COMMISSION
 BOOK PAGE 74 LINE 15 APR 18 1951

CONSTRUCTION

1/10/51

COPY