


STATE OF KANSAS
STATE CORPORATION COMMISSION

15-147-00167-00-00
WELL PLUGGING RECORD

Give All Information Completely
Make Required Affidavit
Mail or Deliver Report to:
Conservation Division
State Corporation Commission
800 Bitting Building
Wichita, Kansas

Phillips County. Sec. 7 Twp. 1 Rge. 18 (X) W (W)
Location as "NE/CNW $\frac{1}{4}$ SW $\frac{1}{4}$ " or footage from lines NW NE NW
Lease Owner Henaker Drilling Co., Inc.
Lease Name Gebhard Well No. 1
Office Address 2008 Lakin, Great Bend, Kansas
Character of Well (completed as Oil, Gas or Dry Hole)
Date well completed 1-8-51 19
Application for plugging filed July 29, 1951
Application for plugging approved June 1, 1951
Plugging commenced June 8, 1951
Plugging completed June 14, 1951
Reason for abandonment of well or producing formation Dry
Well producing 8 bbls. water, 2 bbls. oil per day.
If a producing well is abandoned, date of last production June 1 1951
Was permission obtained from the Conservation Division or its agents before plugging was commenced? Yes

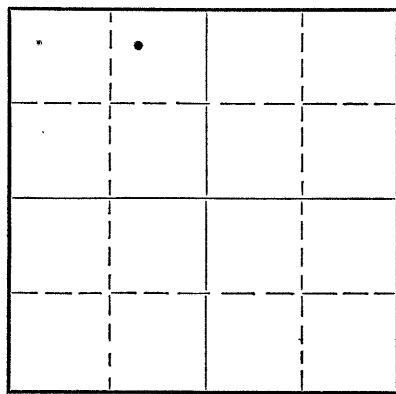

Locate well correctly on above Section Plat

Name of Conservation Agent who supervised plugging of this well Eldon Petty, Hays, Kansas
Producing formation K. C. Lansing Depth to top Bottom Total Depth of Well 3449 Feet
Show depth and thickness of all water, oil and gas formations.

OIL, GAS OR WATER RECORDS

CASING RECORD

Formation	Content	From	To	Size	Put In	Pulled Out
K. C.		0		8-5/8"	165'	Left in
				5-1/2"	3448'	1522'

Describe in detail the manner in which the well was plugged, indicating where the mud fluid was placed and the method or methods used in introducing it into the hole. If cement or other plugs were used, state the character of same and depth placed, from _____ feet to _____ feet for each plug set.

Lane Wells Plug set 3423'. Plug back to 3400 w/ chat. Dumped 4 sacks cement. Mud to 160' set bridge dumped 15 sacks cement. Mud to 35' of surface dumped 10 sacks cement to surface.

RECEIVED
STATE CORPORATION COMMISSION
JUN 26 1951
CONSERVATION DIVISION
Wichita, Kansas

(If additional description is necessary, use BACK of this sheet)

Correspondence regarding this well should be addressed to Henaker Drilling Co., Inc.
Address 2008 Lakin, Great Bend, Kansas

STATE OF Kansas, COUNTY OF Barton, ss.
E. O. Squires (employee of owner) or (owner or operator) of the above-described well,
being first duly sworn on oath, says: That I have knowledge of the facts, statements, and matters herein contained and the log of the above-described well as filed and that the same are true and correct. So help me God.

(Signature) E. O. Squires

(Address)

SUBSCRIBED AND SWORN to before me this 25th day of June 1951

My commission expires

November 28, 1953

Barton Carothers
Notary Public.

PLUGGING
FILE SEC 7 T 1 R 18W
BOOK PAGE 85 LINE 88

23-5091-s

8-50-10M

DRILLERS LOG

Operator: Honaker Drilling Co., Inc.
 Lease: Gebhard #1
 Contractor: Honaker Drilling Co., Inc.

15-147-00167-00-00

Soil & Sand	0	60
Sand	60	130
Shale	130	164

Run 8 joints 3-5/8" new surface casing, 166.74', set at 164' with 125 sacks cement and 200# CaCl.

Shale	164	425
Shale & Shells	425	575
Shale	575	885
Shale & Shells	885	1000
Sand	1000	1020
Shale & Sand	1020	1400
Shale & Shells	1400	1500
Shale & Sand	1500	1680
Shale & Red Bed	1680	1725
Anhydrite	1725	1755
Shale & Red Bed	1755	1810
Red Bed	1810	1840
Shale	1840	1900
Broken Lime	1900	1930
Shale-	1930	1950
Lime & Shale	1950	2250
Lime	2250	2315
Lime & Shale	2315	3100
Lime	3100	3449

T. D.

Run 111 Joints 5 1/2" OD casing, 3450.75', set at 3447' with 175 sacks cement.

The foregoing is correct to the best of my knowledge.

HONAKER DRILLING CO., INC.

By Joe J. Honaker
 President

C
O
P
Y

RECEIVED
 STATE CORPORATION COMMISSION
 PLUGGING
 FILED SEC 7-11-1916
 BOOK PAGE 85-118