


Give All Information Completely
Make Required Affidavit
Mail or Deliver Report to:
Conservation Division
State Corporation Commission
211 No. Broadway
Wichita, Kansas

WELL PLUGGING RECORD

NORTH

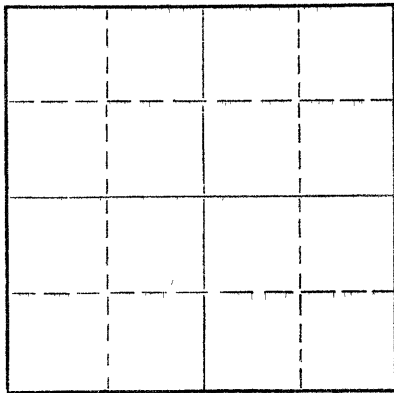

Locate well correctly on above
Section Plat

Phillips

County. Sec. 4 Twp. 1S Rge. (E) 18 (W)

Location as "NE/CNW/SW" or footage from lines NE NE NW

Lease Owner Bovaird Supply Company

Lease Name KAUK Well No. 1

Office Address Box 897 - Gt. Bend, Kansas

Character of Well (completed as Oil, Gas or Dry Hole) Dry Hole

Date well completed _____ 19__

Application for plugging filed 1/11 19 65

Application for plugging approved 1/13 19 65

Plugging commenced _____ 19__

Plugging completed _____ 19__

Reason for abandonment of well or producing formation Dry Hole

If a producing well is abandoned, date of last production _____ 19__

Was permission obtained from the Conservation Division or its agents before plugging was commenced? Yes

Name of Conservation Agent who supervised plugging of this well Eldon Petty

Producing formation _____ Depth to top _____ Bottom _____ Total Depth of Well 3458 Feet

Show depth and thickness of all water, oil and gas formations.

OIL, GAS OR WATER RECORDS

CASING RECORD

FORMATION	CONTENT	FROM	TO	SIZE	PUT IN	PULLED OUT
		0	178	8-5/8"	178	None
		0	3458	5-1/2"	3458	2550.73 Ft.

Describe in detail the manner in which the well was plugged, indicating where the mud fluid was placed and the method or methods used in introducing it into the hole. If cement or other plugs were used, state the character of same and depth placed, from _____ feet to _____ feet for each plug set.

Plugged well with Halliburton per State of Kansas Plugger,
Mr. Eldon Petty

03-25-1965
MAR 25 1965
CONSERVATION DIVISION
Wichita, Kansas

Name of Plugging Contractor Hull Casing Pulling Co.
Address 6125 Janice Way - Arvada, Colorado

STATE OF KANSAS, COUNTY OF BARTON, ss.
G.D. Darnell (employee of owner) or (owner or operator) of the above-described well, being first duly sworn on oath, says: That I have knowledge of the facts, statements, and matters herein contained and the log of the above-described well as filed and that the same are true and correct. So help me God.

(Signature) G. Darnell
Box 897 - Gt. Bend, Kansas
(Address)

SUBSCRIBED AND SWORN TO before me this 22nd day of March 19 65

My commission expires Jan. 26, 1967.
Carmen R. Cook Notary Public.