


WELL PLUGGING RECORD

15-147-20055-00-00

Give All Information Completely
Make Required Affidavit
Mail or Deliver Report to:
Conservation Division
State Corporation Commission
211 No. Broadway
Wichita, Kansas

Phillips County. Sec. 14 Twp. 1 Rge. 18 (E) (W) x

NORTH

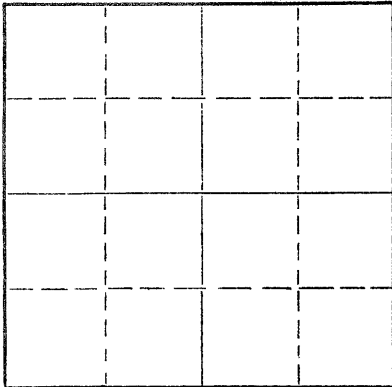

Locate well correctly on above Section Plat

Location as "NE/CNW/SW" or footage from lines SW SW SW
Lease Owner Lowell Keesee
Lease Name Chestnut Well No. #1
Office Address 785 2nd St. Phillipsburg, Kansas
Character of Well (completed as Oil, Gas or Dry Hole) _____
Date well completed _____ 19____
Application for plugging filed 7-24-70 19____
Application for plugging approved _____ 19____
Plugging commenced 7-27-70 19____
Plugging completed 7-29-70 19____
Reason for abandonment of well or producing formation _____

If a producing well is abandoned, date of last production _____ 19____
Was permission obtained from the Conservation Division or its agents before plugging was commenced? _____

Name of Conservation Agent who supervised plugging of this well Leo Massey
Producing formation _____ Depth to top _____ Bottom _____ Total Depth of Well 3533' Feet
Show depth and thickness of all water, oil and gas formations.

OIL, GAS OR WATER RECORDS

CASING RECORD

FORMATION	CONTENT	FROM	TO	SIZE	PUT IN	PULLED OUT
				4 1/2"	3532'	2747.69'
				8 5/8"	215'	

RECEIVED
STATE CORPORATION COMMISSION
JUL 31 1970
CONSERVATION DIVISION
Wichita, Kansas

Describe in detail the manner in which the well was plugged, indicating where the mud fluid was placed and the method or methods used in introducing it into the hole. If cement or other plugs were used, state the character of same and depth placed, from _____ feet to _____ feet for each plug set.

Made bottom hole plug back with sand to 3350'. Mixed and ran 4 sacks cement thru dump bailer.
Squeezed hole with 3 sacks hulls, followed with 15 sacks gel, followed with 70 sacks cement followed with 15 sacks gel, followed with 2 sacks hulls, released plug and displaced with 55 sacks cement.

(If additional description is necessary, use BACK of this sheet)


Name of Plugging Contractor Southwest Casing Pulling Co.
Address Box 364, Great Bend, Kansas 67530

STATE OF Kansas, COUNTY OF Barton, ss.
Southwest Casing Pulling Co. (employee of owner) or (owner or operator) of the above-described well, being first duly sworn on oath, says: That I have knowledge of the facts, statements, and matters herein contained and the log of the above-described well as filed and that the same are true and correct. So help me God.

(Signature) W. C. Spencer Sec.
Box 364, Great Bend, Kansas
(Address)

SUBSCRIBED AND SWORN TO before me this 30 day of July, 1970

My commission expires

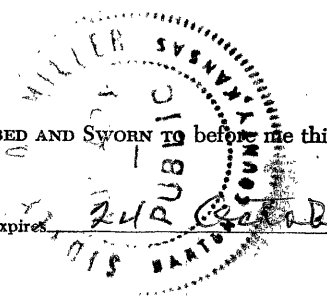

Sidney Miller
Notary Public.

24th October 1972

DRILLERS LOG

No. 1 Chestnut

15-147-20055-00-00

CASING RECORD: COMPANY: Red Barron Productions, Inc. DESCRIPTION:

8 5/8" @ 215' CONTRACTOR: Red Tiger Drilling Co. SW SW SW

w/165 sx. cement COMMENCED: November 17, 1968 14-1S-18W

4 1/2" @ 3532 COMPLETED: November 24, 1968 Phillips County

w/140 sx. cement Kansas

TOTAL DEPTH: 3533' ELEVATION:

<u>FORMATION</u>	<u>FROM</u>	<u>TO</u>	<u>REMARKS</u>
Sand & Shale	0	216	
Shale	216	1360	
Hard Sand	1360	1370	
Shale	1370	1750	
Shale & Shells	1750	2285	
Shale & Lime	2285	3120	
Lime	3120	3533	

RECEIVED
STATE CORPORATION COMMISSION
JUL 27 1970
CONSERVATION DIVISION
Wichita, Kansas

I certify that this is a true and correct copy of the above log to the best of my knowledge.

RED TIGER DRILLING COMPANY

Norman E. Klein
Norman E. Klein

Subscribed and sworn to before me this 3rd day of December, 1968.

Gloria Sawcett
Notary Public

My Commission Expires:

October 25, 1972

