


15-147-30185-00-00

WELL PLUGGING RECORD

Give All Information Completely
Make Required Affidavit
Mail or Deliver Report to:
Conservation Division
State Corporation Commission
800 Bittling Building
Wichita, Kansas

NORTH

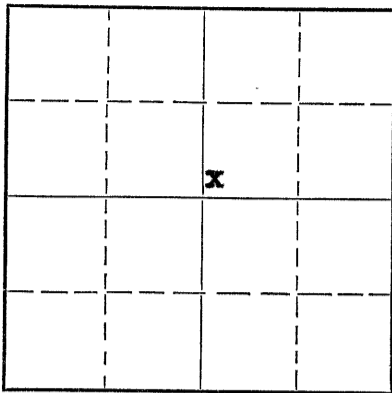

Locate well correctly on above
Section Plat

Phillips County. Sec. 10 Twp. 18 Rge. 18 (E) W (W)
Location as "NE/CNW $\frac{1}{4}$ /SW $\frac{1}{4}$ " or footage from lines SW SW NE
Lease Owner National Associated Petroleum Co.
Lease Name Heth Well No. 1
Office Address Ritz Bldg. Tulsa, Okla.
Character of Well (completed as Oil, Gas or Dry Hole) Dry Hole
Date well completed July 2, 19 51
Application for plugging filed Oct. 22, 19 51
Application for plugging approved Oct. 22, 19 51
Plugging commenced Nov. 14, 19 51
Plugging completed Nov. 19, 19 51
Reason for abandonment of well or producing formation Not commercially productive

If a producing well is abandoned, date of last production _____ 19 ____
Was permission obtained from the Conservation Division or its agents before plugging was commenced? YES

Name of Conservation Agent who supervised plugging of this well Eldon Petty
Producing formation _____ Depth to top _____ Bottom _____ Total Depth of Well 3445 Feet
Show depth and thickness of all water, oil and gas formations.

OIL, GAS OR WATER RECORDS

CASING RECORD

Formation	Content	From	To	Size	Put In	Pulled Out
Lansing-Kansas City	Water and SS0	3292	3414	10-3/4" 5 1/2"	186' 3443'	None 2710.56'

Describe in detail the manner in which the well was plugged, indicating where the mud fluid was placed and the method or methods used in introducing it into the hole. If cement or other plugs were used, state the character of same and depth placed, from _____ feet to _____ feet for each plug set.

Set a brush plug at 3380 ft.
Dumped 20 ft. of Rock to 3360 ft.
Mixed and dumped 5 sacks of cement, into hole.
Pumped Mud Laden Fluid into hole.
Bailed out mud to bottom of surface casing at 186 ft.
Set a brush plug at 186 ft.
Mixed and dumped 20 sacks of cement into hole.
Pumped mud laden fluid to within 30 ft. from top of Hole.
Poured 10 sacks of cement on top.

(If additional description is necessary, use BACK of this sheet)

Name of Plugging Contractor General Casing Pulling Co. (Okla. Corp. Permit # 158)
Address P.O. Box 4387 Okla. City 9, Okla. (1319 SE 29th St.)

STATE OF Oklahoma, COUNTY OF Tulsa, SS.

_____, (employee of owner) or (owner or operator) of the above-described well, being first duly sworn on oath, says: That I have knowledge of the facts, statements, and matters herein contained and the log of the above-described well as filed and that the same are true and correct. So help me God.

(Signature) E. W. Reese
General Production Superintendent
5th Floor Ritz Bldg. - Tulsa, Oklahoma
(Address)

SUBSCRIBED AND SWORN to before me this 3rd day of December, 19 51

Charles M. Carmick
Notary Public.

My commission expires January 13, 1952

23-8390-s 6-51-20M
FILE SET 10 1 185
BOOK PAGE 119 LINE 16

DEC - 4 1951
CONSERVATION DIVISION
WICHITA, KANSAS

15-147-30185-00-00

NATIONAL ASSOCIATED PETROLEUM COMPANY
HETH #1

SW SW NE Sec. 10-18-18W
Phillips County, Kansas

Casing

10 3/4" Set @ 186'
5 1/2" Set @ 3443

Cement

125 Sacks
150 Sacks

Comm: 6-9-51
Comp: 6-20-51
Total Depth: 3438'

<u>FORMATION</u>	<u>DEPTH</u>
Sand & clay	0 - 40
Sand & shale	40 - 150
Shells & shale	150 - 186
Sand shale	186 - 340
Shale	340 - 490
Shale shells	490 - 900
Sand	900 - 1000
Shale shells	1000 - 1330
Sand	1330 - 1465
Shale & shells	1465 - 2290
Shale & lime	2290 - 2550
Shale & shells	2550 - 2635
Shale & lime	2635 - 2800
Shale & shells	2800 - 2870
Shale & lime	2870 - 2925
Lime streaks - shale	2925 - 3015
Lime & shale	3015 - 3175
Lime	3175 - 3225
Shale & lime	3225 - 3314
Lime	3314 - 3443

REGISTRATION
STATE CORPORATION
OCT 26 1951
CONSERVATION
Wichita Falls

STATE OF KANSAS)
) SS
SEDGWICK COUNTY)

I hereby certify that the above information is true and correct
to the best of my knowledge.

[Signature]

Subscribed and sworn to before me this 25th day of June, 1951.

[Signature]
Notary Public

My commission expires: 6-5-54

PLUGGING
FILE SEC 10 T 1 R 18W
BOOK PAGE 119 LINE 16

JUN 26 1951