

TYPE

AFFIDAVIT OF COMPLETION FORM

ACO-1 WELL HISTORY

SIDE ONE

Two (2) copies of this form shall be filed with the Kansas Corporation Commission, 200 Colorado Derby Building, Wichita, Kansas 67202, within thirty (30) days after the completion of a well, regardless of how the well was completed.

Attach separate letter of request if the information is to be held confidential. If confidential, only file one copy. Information on Side One will be of public record and Side Two will then be held confidential.


Applications must be made on dual completion, commingling, salt water disposal, injection and temporarily abandoned wells.

Attach one copy only wireline logs (i.e. electrical log, sonic log, gamma ray neutron log, etc.). (Rules 82-2-105 & 82-2-125) KCC# (316) 263-3238.

LICENSE # 6029 EXPIRATION DATE 6-30-83
OPERATOR Ladd Petroleum Corporation API NO. 15-147-20, 405-20-00
ADDRESS 830 Denver Club Bldg. COUNTY Phillips
Denver, Colorado 80202 FIELD Huffstutter
** CONTACT PERSON Bill Riley PROD. FORMATION LKC
PHONE 316-792-3571

PURCHASER _____ LEASE Jackson "F"
ADDRESS _____ WELL NO. 4
DRILLING Murfin Drlg. Co. WELL LOCATION Approx w $\frac{1}{2}$ SW-SE
CONTRACTOR 617 Union Center Bldg. 650 Ft. from S Line and
ADDRESS Wichita, Kansas 67202 2300 Ft. from E Line of
the SE (Qtr.) SEC 21 TWP 1 RGE 18.

PLUGGING Same
CONTRACTOR _____
ADDRESS _____

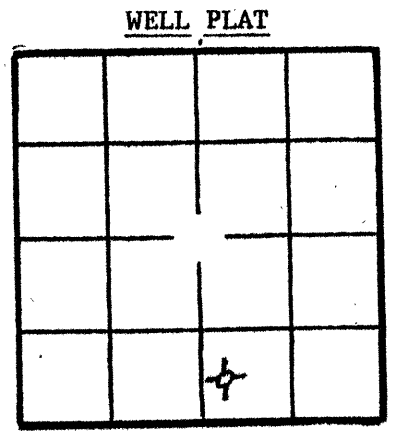

(Office Use Only)
KCC
KGS
SWD/REP _____
PLG. _____

TOTAL DEPTH 3630 PBD _____
SPUD DATE 3-21-83 DATE COMPLETED 3-28-83
ELEV: GR 2193 DF _____ KB 2198
DRILLED WITH (CABLE) (ROTARY) (AIR) TOOLS.
DOCKET NO. OF DISPOSAL OR REPRESSURING WELL BEING USED TO DISPOSE OF WATER FROM THIS LEASE _____

Amount of surface pipe set and cemented 249 DV Tool Used? -

THIS AFFIDAVIT APPLIES TO: (Circle ONE) - Oil, Gas, Shut-in Gas, (Dry) Disposal, Injection, Temporarily Abandoned, OWWO. Other _____

ALL REQUIREMENTS OF THE STATUTES, RULES AND REGULATIONS PROMULGATED TO REGULATE THE OIL AND GAS INDUSTRY HAVE BEEN FULLY COMPLIED WITH.


A F F I D A V I T

William Riley, being of lawful age, hereby certifies that:

I am the Affiant, and I am familiar with the contents of the foregoing Affidavit. The statements and allegations contained therein are true and correct.

William V. Riley
(Name)

SUBSCRIBED AND SWORN TO BEFORE ME this 18th day of July, 1983.

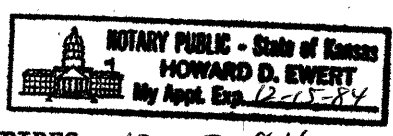

Howard D. Ewert
(NOTARY PUBLIC)

MY COMMISSION EXPIRES: 12-15-84

RECEIVED
STATE CORPORATION COMMISSION
July 20, 1983
JUL 20 1983

** The person who can be reached by phone regarding any questions concerning this information.

OPERATOR

Ladd Petroleum Corporation LEASE Jackson "F"

NOV. 21 1971 1 RGL 18W

FILL IN WELL LOG AS REQUIRED:

Show all important zones of porosity and contents thereof; cored intervals, and all drill-stem tests, including depth interval tested, cushion used, time tool open, flowing and shut-in pressures, and recoveries.

SHOW GEOLOGICAL MARKERS, LOSS RUN, OR OTHER DESCRIPTIVE INFORMATION.

FORMATION DESCRIPTION, CONTENTS, ETC.	TOP	BOTTOM	NAME	DEPTH
Lime/Shale	-1188		LKC	3386
Lime/Shale	-1432			3630
DST #1 3406-3432 30-30-30-30 Rec: 10' GIP, 5' MCO, 50' OCM IHP 1716 IFP 35-35 ISIP 1237 FHP 1716 FFP 46-46 FSIP 1180				
DST #2 3439-3445 30-30-30-30 Rec: 20' SOCM IHP 1727 IFP 23-23 ISIP 1180 FHP 1682 FFP 35-35 FSIP 1089				

Report of all strings set— surface, intermediate, production, etc. **CASING RECORD (New) or (Used)**

Purpose of string	Size hole drilled	Size casing set (in O.D.)	Weight lbs/ft.	Setting depth	Type cement	Sacks	Type and percent additives
Surface	12 1/4	8 5/8	24	242	Common	190	3% CaCl 2% Gel

LINER RECORD

PERFORATION RECORD

Top, ft.	Bottom, ft.	Sacks cement	Shots per ft.	Size & type	Depth interval
N/A					

TUBING RECORD

Size	Setting depth	Packer set at
N/A		

ACID, FRACTURE, SHOT, CEMENT SQUEEZE RECORD

Amount and kind of material used	Depth interval treated
N/A	

Date of first production	Producing method (flowing, pumping, gas lift, etc.)	Gravity
Dry		

RATE OF PRODUCTION PER 24 HOURS	Oil	Gas	Water	Gas-oil ratio
Dry	50%	MCF	%	bbbl

Disposition of gas (vented, used on lease or sold) **Perforations**