

15-147-30029-00-00


Form CP-4

STATE OF KANSAS  
STATE CORPORATION COMMISSION

WELL PLUGGING RECORD

Give All Information Completely  
Make Required Affidavit  
Mail or Deliver Report to:  
Conservation Division  
State Corporation Commission  
211 No. Broadway  
Wichita, Kansas

NORTH

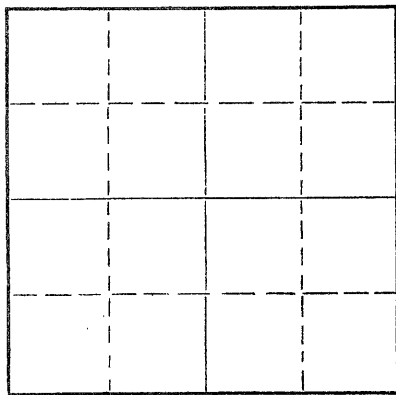

Locate well correctly on above  
Section Plat

Phillips County. Sec. 17 Twp. 1S Rge. 18W(E) (W)  
Location as "NE/CNW/SW" or footage from lines C W/2 SE NE  
Lease Owner Livingston Oil Company  
Lease Name Lutjeharm Well No. 5  
Office Address 9 East Fourth, Tulsa, Oklahoma  
Character of Well (completed as Oil, Gas or Dry Hole) D & A  
Date well completed May 24 19 65  
Application for plugging filed May 24 19 65  
Application for plugging approved May 24 19 65  
Plugging commenced May 24 19 65  
Plugging completed May 24 19 65  
Reason for abandonment of well or producing formation D & A

If a producing well is abandoned, date of last production 19  
Was permission obtained from the Conservation Division or its agents before plugging was commenced? Yes

Name of Conservation Agent who supervised plugging of this well Eldon Petty  
Producing formation Depth to top Bottom Total Depth of Well 3570 Feet  
Show depth and thickness of all water, oil and gas formations.

OIL, GAS OR WATER RECORDS

CASING RECORD

FORMATION	CONTENT	FROM	TO	SIZE	PUT IN	PULLED OUT
				8 5/8"	200'	--0--

Describe in detail the manner in which the well was plugged, indicating where the mud fluid was placed and the method or methods used in introducing it into the hole. If cement or other plugs were used, state the character of same and depth placed, from feet to feet for each plug set.

Fill with heavy mud to  
540', plug w/20 sx cement.  
Fill w/heavy mud to 190',  
plug w/20 sx cement. Fill  
w/heavy mud to 35', 1/2 sx  
hulls, 10 sx cement.

RECEIVED  
STATE CORPORATION COMMISSION

MAY 28 1965

CONSERVATION DIVISION  
Wichita, Kansas

(If additional description is necessary, use BACK of this sheet)

Name of Plugging Contractor Red Tiger Drilling Company  
Address Box 173--Russell, Kansas

STATE OF KANSAS, COUNTY OF SEDGWICK, ss.  
Maxine V. Head (employee of owner) of the above-described well, being first duly sworn on oath, says: That I have knowledge of the facts, statements, and matters herein contained and the log of the above-described well as filed and that the same are true and correct. So help me God.

(Signature) Maxine V. Head  
1720 Wichita Plaza, Wichita, Kansas  
(Address)

SUBSCRIBED AND SWORN to before me this 25th day of May, 19 65

Jean Holler  
Notary Public.

My commission expires 5-22-66

W15-147-30029-00-00

DRILLERS LOG

No. 5 Lutjeharm

<b>CASING RECORD:</b>	<b>COMPANY:</b>	Livingston Oil Company	<b>DESCRIPTION:</b>
8 5/8" @ 200'	<b>CONTRACTOR:</b>	Red Tiger Drilling Co.	C W/2 SE NE
w/135 sx cement	<b>COMMENCED:</b>	May 19, 1965	17-1S-18W
	<b>COMPLETED:</b>	May 24, 1965	Phillips Co., Ks.
<b>TOTAL DEPTH:</b> 3570'			<b>ELEVATION:</b>

<u>FORMATION</u>	<u>FROM</u>	<u>TO</u>	<u>REMARKS</u>
Surface Soil	0	220	
Shale	220	2365	
Lime & Shale	2365	3225	
Lime	3225	3570	

I certify that this is a true and correct copy of the above log to the best of my knowledge.

RED TIGER DRILLING COMPANY

Maxine V. Head  
Maxine V. Head

Subscribed and sworn to before me this 25th day of May, 1965.

Jean Hollan  
Notary Public

My Commission Expires:

5-22-68

**RECEIVED**  
STATE CORPORATION COMMISSION  
FEB 10 1966  
CONSERVATION DIVISION  
Wichita, Kansas