


STATE OF KANSAS
STATE CORPORATION COMMISSION

Give All Information Completely
Make Required Affidavit
Mail or Deliver Report to:
Conservation Division
State Corporation Commission
800 Bitting Building
Wichita, Kansas

15-147-19029-00-00
WELL PLUGGING RECORD

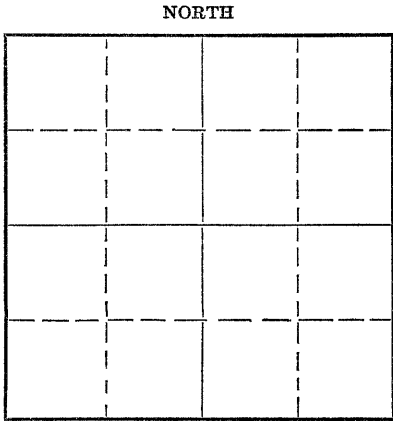

Locate well correctly on above
Section Plat

Phillips County. Sec. 16 Twp. 1 Rge. 18 (E) W. (W)
Location as "NE/CNW $\frac{1}{4}$ SW $\frac{1}{4}$ " or footage from lines SE SE SE
Lease Owner B & R Drilling, Inc.
Lease Name IMM "D" Well No. 1
Office Address Russell, Kansas
Character of Well (completed as Oil, Gas or Dry Hole) Dry
Date well completed 8/12/51 19
Application for plugging filed 12/12/51 19
Application for plugging approved 12/12/51 19
Plugging commenced 12/18/51 19
Plugging completed 12/18/51 19
Reason for abandonment of well or producing formation Dry Hole

If a producing well is abandoned, date of last production 19
Was permission obtained from the Conservation Division or its agents before plugging was commenced? Yes

Name of Conservation Agent who supervised plugging of this well Eldon Petty
Producing formation Depth to top Bottom Total Depth of Well 3440 Feet
Show depth and thickness of all water, oil and gas formations.

OIL, GAS OR WATER RECORDS

CASING RECORD

Formation	Content	From	To	Size	Put In	Pulled Out
				8 5/8	194	None

Describe in detail the manner in which the well was plugged, indicating where the mud fluid was placed and the method or methods used in introducing it into the hole. If cement or other plugs were used, state the character of same and depth placed, from feet to feet for each plug set.

PLUGGING RECORD

Plugged back to 3315' with crushed rock, dumped 4 sax cement at 3315' with dump bailer. Top of cement 3287'. Mudded hole to 194', set rock bridge dumped 15 sax cement at 194', top of cement 148'. Mudded hole to 35', dumped 10 sax of cement for cap.

(If additional description is necessary, use BACK of this sheet)

Name of Plugging Contractor
Address

STATE OF STATE OF KANSAS COUNTY OF RUSSELL, ss.
W. A. Michaelis, Jr. (employee of owner) or (owner or operator) of the above-described well,
being first duly sworn on oath, says: That I have knowledge of the facts, statements, and matters herein contained and the log of the above-described well as filed and that the same are true and correct. So help me God.

(Signature) *W. A. Michaelis, Jr.*
Russell, Kansas
(Address)

SUBSCRIBED AND SWORN TO before me this 26th day of December, 1951

My commission expires 6-17-54.

Notary Public.

23-8390-s 6-51-20M

DEC 28 1951

PLUGGING
FILE SEC 16 T 1 R 18 W
BOOK PAGE 132 LINE 44

B & R Drilling, Inc.
Imm "D" No. 1

SE SE SE Of Section 16-1-18W
Phillips County, Kansas

Total Depth: 3440'
Comm: 8-1-51
Comp: 8-12-51

15-147-19029-00-00

Casing

8 5/8" Set @ 194'
5 1/2" Set @ 3439'

Cement

125 Sacks of Victor
150 Sacks of Victor

Formation	Depth
Shale-Shells-Sand	194
Shale-Shells	339
Shale-Shells-Sand	1280
Shale-Sand	1700
Shale-Shells	2020
Lime-Shells-Shale	2235
Lime-Shale-F.R.	2325
Shale-Lime-Pyrite	2415
Ft. Riley	2465
Shale-Sand	2560
Lime-Shale	3395
Lime	3418
Lime-Shale	3440'

STATE OF KANSAS)
)SS
RUSSELL COUNTY)

I hereby certify that the above information
is true and correct to the best of my knowledge.

Caro Betty

Subscribed and sworn to before me this 22nd day of August, 1951.

Clara L. Linn

Notary Public

My commission expires: 6-17-54

FILE NO. 16-1-18W
BOOK PAGE 1321 LINE 44

DEC 28 1951

PHILLIPS COUNTY DIVISION