

STATE OF KANSAS
STATE CORPORATION COMMISSION

15-147-20230-00-00

WELL PLUGGING RECORD

Give All Information Completely
Make Required Affidavit
Mail or Deliver Report to
Conservation Division
State Corporation Comm.
245 North Water
Wichita, KS 67202

Phillips County, Sec. 16 Twp. 18 Rge. 18 E/W
Location as "NE/CNW $\frac{1}{4}$ SW $\frac{1}{4}$ " or footage from lines
C NW NE


Lease Owner Ladd Petroleum Corp.
Lease Name Scott A Well No. 1
Office Address 830 Denver Club Bldg., Denver, Colo.
Character of Well (Completed as Oil, Gas or Dry Hole) 80202
oil

Date Well completed _____ 19____
Application for plugging filed _____ 19____
Application for plugging approved April 10 1980
Plugging commenced May 1 1980
Plugging completed May 6 1980
Reason for abandonment of well or producing formation
depleted

If a producing well is abandoned, date of last production
_____ 19____

Was permission obtained from the Conservation Division or
its agents before plugging was commenced? yes

Name of Conservation Agent who supervised plugging of this well Marion Schmidt
Producing formation _____ Depth to top _____ Bottom _____ Total Depth of Well 3581'
Show depth and thickness of all water, oil and gas formations.

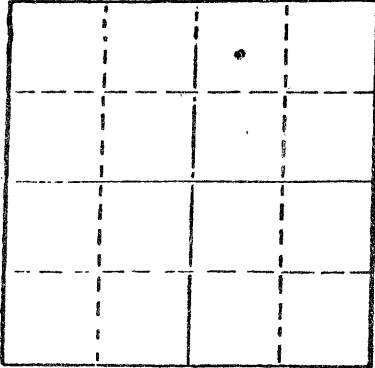

Locate well correctly on above
Section Plat

OIL, GAS OR WATER RECORDS

CASING RECORD

| FORMATION | CONTENT | FROM | TO | SIZE | PUT IN | PULLED OUT |
|-----------|---------|------|-------|--------|--------|------------|
| | | | 286' | 8 5/8" | 286' | none |
| | | | 3579' | 5 1/2" | 3579' | 517.35 |
| | | | | | | |
| | | | | | | |

Describe in detail the manner in which the well was plugged, indicating where the mud fluid was placed and the method or methods used in introducing it into the hold. If cement or other plugs were used, state the character of same and depth placed, from _____ feet to _____ feet for each plug set.

Sanded back to 3300' and dumped 5 sacks of cement.

Allied Cementing, Inc. plugged well pumping in 5 sacks of hulls, 14 sacks of gel and 135 sacks of cement.

RECEIVED
STATE CORPORATION COMMISSION

MAY - 9 1980


(If additional description is necessary, use BACK of this sheet)
Name of Plugging Contractor GLENNS CASING PULLING INC.
Box 413, Ellinwood, Kansas 67526

STATE OF KANSAS COUNTY OF BARTON, ss.
Evelyn Roth (employee of owner) or (~~owner or operator~~)
of the above-described well, being first duly sworn on oath, says: That I have knowledge of the facts, statements, and matters herein contained and the log of the above-described well as filed and that the same are true and correct. So help me God.

(Signature) Evelyn Roth
Ellinwood, Kansas (Address)

SUBSCRIBED AND SWORN TO before me this 8th day of May, 1980

My commission expires

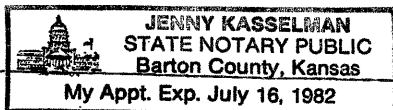

Jenny Kasselmann
Notary Public.