

IN ALL CASES PLOT THE INTENDED WELL ON THE PLAT BELOW

Show the relationship to other wells or facilities proposed to be serviced by the intended cathodic borehole. Please show all the wells, existing cathodic boreholes, pipelines or facilities within 1/2 mile of the proposed borehole.

API NO. 15-
OPERATOR Kansas City Power and Light
LEASE KCPM CW
WELL NUMBER 1A
FACILITY NAME Kansas City Power and Light

LOCATION OF WELL: COUNTY Johnson
1579 feet from south/north line of section
1035 feet from east/west line of section
SECTION 17 TWP 15 RG 22

SPOT: QTR/QTR/QTR/QTR OF ACREAGE
E1/2 - SE1/4 - -


IS SECTION X REGULAR or IRREGULAR
IF SECTION IS IRREGULAR, LOCATE WELL FROM NEAREST CORNER BOUNDARY.

Section corner used: NE NW SE SW

PLAT

(Show location of intended cathodic borehole.)

(Show footage from nearest lease, unit or outside section boundary line.)

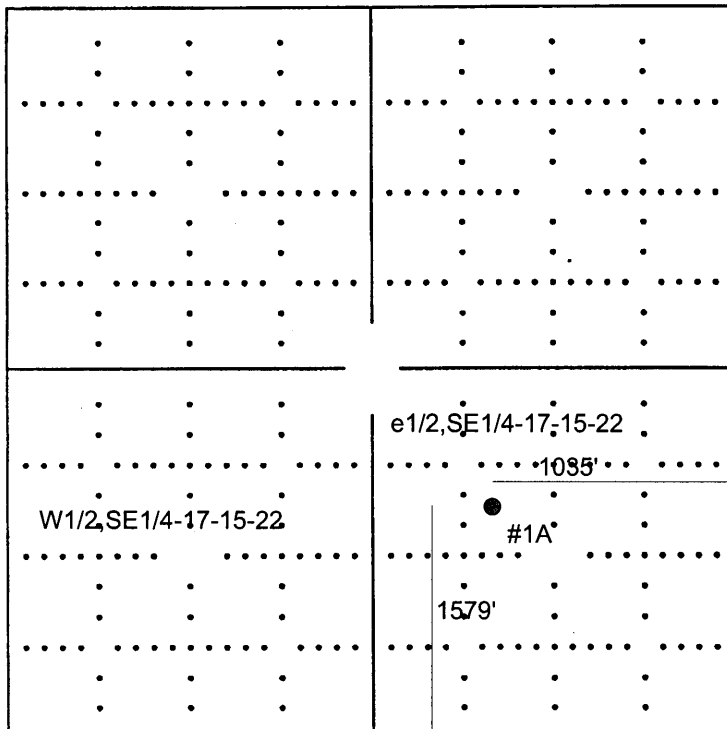


Johnson County, KS

RECEIVED
KANSAS CORPORATION COMMISSION

MAR 10 2004

CONSERVATION DIVISION
WICHITA, KS

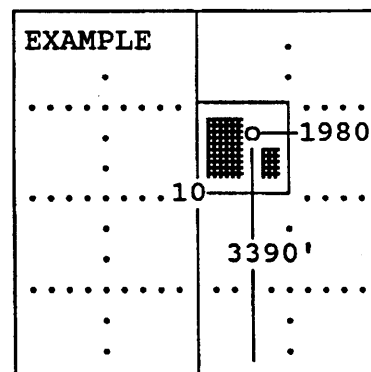

SEWARD CO.

In plotting the proposed location of the well, you must show:

- 1) The manner in which you are using the depicted plat by identifying section lines, i.e. 1 section, 1 section with 8 surrounding sections, 4 sections, etc.;
- 2) the distance of the proposed drilling location from the section's south/north and east/west; and
- 3) the distance to the nearest lease, unit or outside section boundary line.