

RECEIVED

For KCC Use: 3-8-04  
Effective Date: \_\_\_\_\_  
District # \_\_\_\_\_  
SGA?  Yes  No

KANSAS CORPORATION COMMISSION **MAR 03 2004**  
OIL & GAS CONSERVATION DIVISION  
**NOTICE OF INTENT TO DRILL KCC WICHITA**

Form C-1  
December 2002  
Form must be Typed  
Form must be Signed  
All blanks must be Filled

Must be approved by KCC five (5) days prior to commencing well

Expected Spud Date 03/9/04  
month day year

Spot  East  
SW SE NW Sec. 28 Twp. 28 S. R. 21  West  
2970 feet from  N /  S Line of Section  
3630 feet from  E /  W Line of Section

OPERATOR: License# 8061  
Name: Oil Producers, Inc. of Kansas  
Address: P.O. Box 8647  
City/State/Zip: Wichita, Ks. 67208  
Contact Person: Diana Richecky  
Phone: 316-681-0231

Is SECTION  Regular  Irregular?

CONTRACTOR: License# 4958  
Name: Mallard JV Inc.

(Note: Locate well on the Section Plat on reverse side)  
County: Ford  
Lease Name: Kirkpatrick Well #: 1-28

Field Name: \_\_\_\_\_  
Is this a Prorated / Spaced Field?  Yes  No

Target Formation(s): Mississippi  
Nearest Lease or unit boundary: 330

Ground Surface Elevation: 2404 feet MSL  
Water well within one-quarter mile:  Yes  No

Public water supply well within one mile:  Yes  No  
Depth to bottom of fresh water: 180

Depth to bottom of usable water: 400  
Surface Pipe by Alternate:  1  2

Length of Surface Pipe Planned to be set: 300-420 MIN!  
Length of Conductor Pipe required: None

Projected Total Depth: 5250  
Formation at Total Depth: Mississippi

Water Source for Drilling Operations:  
 Well  Farm Pond Other Haul

DWR Permit #: \_\_\_\_\_  
(Note: Apply for Permit with DWR )  
Will Cores be taken?  Yes  No

If Yes, proposed zone: \_\_\_\_\_

Well Drilled For:  Oil  Enh Rec  Infield  Pool Ext.  Wildcat  Other  
 Gas  Storage  Disposal  Other  
 OWWO  Seismic; # of Holes \_\_\_\_\_  
Type Equipment:  Mud Rotary  Air Rotary  Cable

If OWWO: old well information as follows:  
Operator: \_\_\_\_\_  
Well Name: \_\_\_\_\_  
Original Completion Date: \_\_\_\_\_ Original Total Depth: \_\_\_\_\_

Directional, Deviated or Horizontal wellbore?  Yes  No  
If Yes, true vertical depth: \_\_\_\_\_  
Bottom Hole Location: \_\_\_\_\_  
KCC DKT #: \_\_\_\_\_

**AFFIDAVIT**

The undersigned hereby affirms that the drilling, completion and eventual plugging of this well will comply with K.S.A. 55 et. seq.

It is agreed that the following minimum requirements will be met:

1. Notify the appropriate district office **prior** to spudding of well;
2. A copy of the approved notice of intent to drill **shall be** posted on each drilling rig;
3. The minimum amount of surface pipe as specified below **shall be set** by circulating cement to the top; in all cases surface pipe **shall be set** through all unconsolidated materials plus a minimum of 20 feet into the underlying formation.
4. If the well is dry hole, an agreement between the operator and the district office on plug length and placement is necessary **prior to plugging**;
5. The appropriate district office will be notified before well is either plugged or production casing is cemented in;
6. If an ALTERNATE II COMPLETION, production pipe shall be cemented from below any usable water to surface within **120 days** of spud date.  
Or pursuant to Appendix "B" - Eastern Kansas surface casing order #133,891-C, which applies to the KCC District 3 area, alternate II cementing must be completed within 30 days of the spud date or the well shall be plugged. **in all cases, NOTIFY district office** prior to any cementing.

I hereby certify that the statements made herein are true and to the best of my knowledge and belief.

Date: 3/2/2004 Signature of Operator or Agent: \_\_\_\_\_ Title: President

For KCC Use ONLY  
API # 15 - 057-20568-00-00  
Conductor pipe required NONE feet  
Minimum surface pipe required 420 feet per Alt.   
Approved by: RJP 3-3-04  
This authorization expires: 9-3-04  
(This authorization void if drilling not started within 6 months of effective date.)  
Spud date: \_\_\_\_\_ Agent: \_\_\_\_\_

**Remember to:**

- File Drill Pit Application (form CDP-1) with Intent to Drill;
- File Completion Form ACO-1 within 120 days of spud date;
- File acreage attribution plat according to field proration orders;
- Notify appropriate district office 48 hours prior to workover or re-entry;
- Submit plugging report (CP-4) after plugging is completed;
- Obtain written approval before disposing or injecting salt water.
- If this permit has expired (See: authorized expiration date) please check the box below and return to the address below.

Well Not Drilled - Permit Expired  
Signature of Operator or Agent: \_\_\_\_\_  
Date: \_\_\_\_\_

Mail to: KCC - Conservation Division, 130 S. Market - Room 2078, Wichita, Kansas 67202

28  
28  
2/1

RECEIVED

MAR 03 2004

KCC WICHITA

IN ALL CASES PLOT THE INTENDED WELL ON THE PLAT BELOW

Plat of acreage attributable to a well in a prorated or spaced field

If the intended well is in a prorated or spaced field, please fully complete this side of the form. If the intended well is in a prorated or spaced field complete the plat below showing that the well will be properly located in relationship to other wells producing from the common source of supply. Please show all the wells and within 1 mile of the boundaries of the proposed acreage attribution unit for gas wells and within 1/2 mile of the boundaries of the proposed acreage attribution unit for oil wells.

API No. 15 - \_\_\_\_\_
Operator: Oil Producers, Inc. of Kansas
Lease: Kirkpatrick
Well Number: 1-28
Field: \_\_\_\_\_

Location of Well: County: Ford
2970 feet from N / S Line of Section
3630 feet from E / W Line of Section
Sec. 28 Twp. 28 S. R. 21 East West

Number of Acres attributable to well: \_\_\_\_\_
QTR / QTR / QTR of acreage: SW - SE - NW

Is Section: Regular or Irregular


If Section is Irregular, locate well from nearest corner boundary.

Section corner used: NE NW SE SW


PLAT

(Show location of the well and shade attributable acreage for prorated or spaced wells.)

(Show footage to the nearest lease or unit boundary line.)

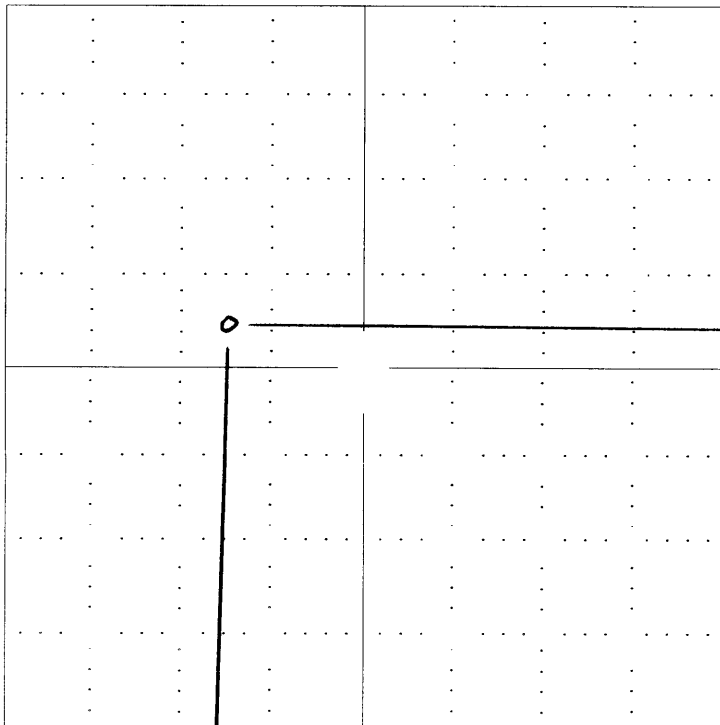

Handwritten note: 3630'

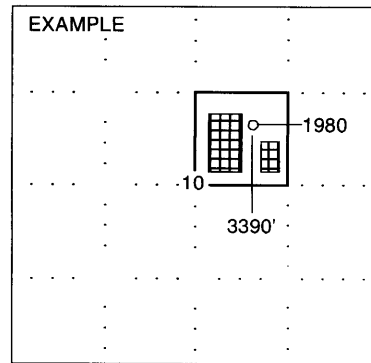

SEWARD CO.

NOTE: In all cases locate the spot of the proposed drilling locaton.

Handwritten note: 2970'

In plotting the proposed location of the well, you must show:

- 1. The manner in which you are using the depicted plat by identifying section lines, i.e. 1 section, 1 section with 8 surrounding sections, 4 sections, etc.
2. The distance of the proposed drilling location from the section's south / north and east / west.
3. The distance to the nearest lease or unit boundary line.
4. If proposed location is located within a prorated or spaced field a certificate of acreage attribution plat must be attached: (C0-7 for oil wells; CG-8 for gas wells).