

OWWO

RECEIVED

FEB 06 2004

Form C-1
December 2002
Form must be Typed
Form must be Signed
blanks must be Filled

For KCC Use: 3-21-04
Effective Date: _____
District # 1
SGA? Yes No

KANSAS CORPORATION COMMISSION
OIL & GAS CONSERVATION DIVISION
NOTICE OF INTENT TO DRILL

Must be approved by KCC five (5) days prior to commencing well.

KCC WICHITA

Expected Spud Date 3/15/2004
month day year

Spot C NW NW Sec. 2 Twp. 32 S. R. 33
 East West
4620 feet from N / S Line of Section
4620 feet from E / W Line of Section

OPERATOR: License# 8061
Name: Oil Producers, Inc. of Kansas
Address: P.O. Box 8647
City/State/Zip: Wichita, Ks. 67208
Contact Person: Diana Richecky
Phone: 316-681-0231

Is SECTION _____ Regular _____ Irregular?
(Note: Locate well on the Section Plat on reverse side)
County: SEWARD
Lease Name: LEMERT Well #: 1-2
Field Name: HUGOTON
Is this a Prorated / Spaced Field? - Hugoton chase Yes No
Target Formation(s): chase

CONTRACTOR: License# ADVISE ON ACO-1
Name: MUST BE KCC LICENSED

Well Drilled For: Well Class: Type Equipment:
 Oil Enh Rec Infield Mud Rotary
 Gas Storage Pool Ext. Air Rotary
 OWWO Disposal Wildcat Cable
 Seismic; # of Holes Other
 Other

Nearest Lease or unit boundary: 660
Ground Surface Elevation: 2884 feet MSL
Water well within one-quarter mile: Yes No
Public water supply well within one mile: Yes No
Depth to bottom of fresh water: 500
Depth to bottom of usable water: 540
Surface Pipe by Alternate: 1 2
Length of Surface Pipe Planned to be set: already set @ 1805'
Length of Conductor Pipe required: NONE
Projected Total Depth: 2900
Formation at Total Depth: chase
Water Source for Drilling Operations:
 Well Farm Pond Other haul
DWR Permit #: _____

If OWWO: old well information as follows:
Operator: Global NAT. RES.
Well Name: Lemert 1-2
Original Completion Date: 7/1/87 Original Total Depth: 6000'

Directional, Deviated or Horizontal wellbore? Yes No
If Yes, true vertical depth: _____
Bottom Hole Location: _____
KCC DKT #: _____

(Note: Apply for Permit with DWR)
Will Cores be taken? Yes No
If Yes, proposed zone: _____

WLE FILED: 2-6-04
WLE APPROVE: 3-16-04

AFFIDAVIT SEE WLE 04. CONS-220-CWLE

The undersigned hereby affirms that the drilling, completion and eventual plugging of this well will comply with K.S.A. 55 et. seq.

It is agreed that the following minimum requirements will be met:

1. Notify the appropriate district office **prior** to spudding of well;
2. A copy of the approved notice of intent to drill **shall be** posted on each drilling rig;
3. The minimum amount of surface pipe as specified below **shall be set** by circulating cement to the top; in all cases surface pipe **shall be set** through all unconsolidated materials plus a minimum of 20 feet into the underlying formation.
4. If the well is dry hole, an agreement between the operator and the district office on plug length and placement is necessary **prior to plugging**;
5. The appropriate district office will be notified before well is either plugged or production casing is cemented in;
6. If an ALTERNATE II COMPLETION, production pipe shall be cemented from below any usable water to surface within **120 days** of spud date. Or pursuant to Appendix "B" - Eastern Kansas surface casing order #133,891-C, which applies to the KCC District 3 area, alternate II cementing must be completed within 30 days of the spud date or the well shall be plugged. **In all cases, NOTIFY district office** prior to any cementing.

I hereby certify that the statements made herein are true and to the best of my knowledge and belief.

Date: 2/5/2004 Signature of Operator or Agent: [Signature] Title: President

For KCC Use ONLY
API # 15 - 175-20694-00-01
Conductor pipe required NONE feet
Minimum surface pipe required 1805' feet per Alt. 1
Approved by RJP 3-16-04
This authorization expires: 9-16-04
(This authorization void if drilling not started within 6 months of effective date.)
Spud date: _____ Agent: _____

Remember to:

- File Drill Pit Application (form CDP-1) with Intent to Drill;
- File Completion Form ACO-1 within 120 days of spud date;
- File acreage attribution plat according to field proration orders;
- Notify appropriate district office 48 hours prior to workover or re-entry;
- Submit plugging report (CP-4) after plugging is completed;
- Obtain written approval before disposing or injecting salt water.
- If this permit has expired (See: authorized expiration date) please check the box below and return to the address below.

Well Not Drilled - Permit Expired
Signature of Operator or Agent: _____
Date: _____

Mail to: KCC - Conservation Division, 130 S. Market - Room 2078, Wichita, Kansas 67202

2-32-334

RECEIVED
FEB 06 2004
KCC WICHITA

IN ALL CASES PLOT THE INTENDED WELL ON THE PLAT BELOW

Plat of acreage attributable to a well in a prorated or spaced field

If the intended well is in a prorated or spaced field, please fully complete this side of the form. If the intended well is in a prorated or spaced field complete the plat below showing that the well will be properly located in relationship to other wells producing from the common source of supply. Please show all the wells and within 1 mile of the boundaries of the proposed acreage attribution unit for gas wells and within 1/2 mile of the boundaries of the proposed acreage attribution unit for oil wells.

API No. 15 - 15-175-20964-0001
Operator: Oil Producers, Inc. of Kansas
Lease: LEMERT
Well Number: 1-2
Field: HUGOTON

Location of Well: County: SEWARD
4620 feet from N / S Line of Section
4620 feet from E / W Line of Section
Sec. 2 Twp. 32 S. R. 33 East West

Number of Acres attributable to well: _____
QTR / QTR / QTR of acreage: C - NW - NW

Is Section: Regular or Irregular



If Section is Irregular, locate well from nearest corner boundary.

Section corner used: NE NW SE SW

PLAT

(Show location of the well and shade attributable acreage for prorated or spaced wells.)

(Show footage to the nearest lease or unit boundary line.)

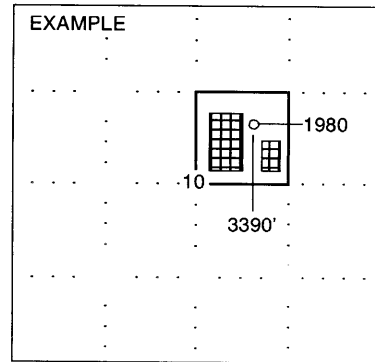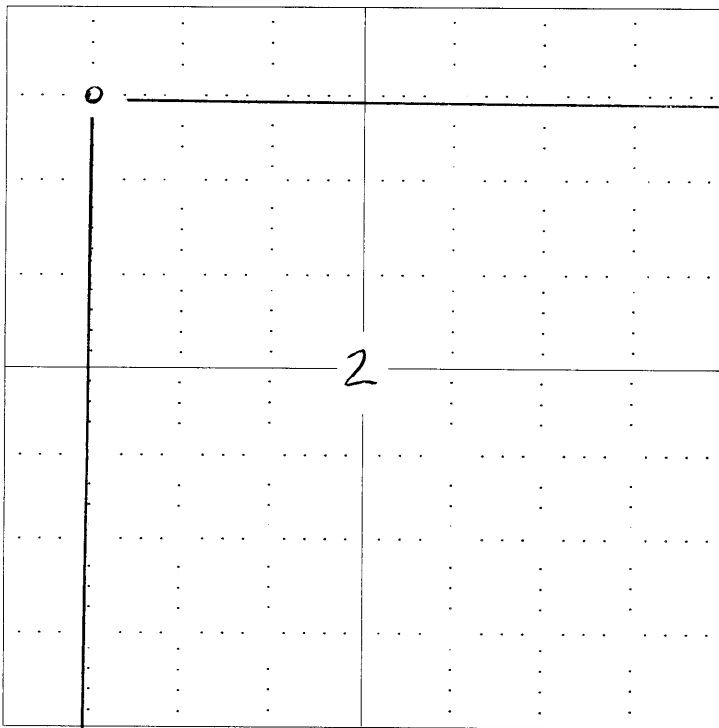

NOTE: In all cases locate the spot of the proposed drilling location.

4620'

In plotting the proposed location of the well, you must show:

1. The manner in which you are using the depicted plat by identifying section lines, i.e. 1 section, 1 section with 8 surrounding sections, 4 sections, etc.
2. The distance of the proposed drilling location from the section's south / north and east / west.
3. The distance to the nearest lease or unit boundary line.
4. If proposed location is located within a prorated or spaced field a certificate of acreage attribution plat must be attached: (CO-7 for oil wells; CG-8 for gas wells).