

FIRST CORRECTED

KANSAS CORPORATION COMMISSION RECEIVED OIL & GAS CONSERVATION DIVISION

Form C-1 December 2002

Form must be Typed Form must be Signed All blanks must be Filled

For KCC Use: Effective Date: 2-25-04 District # 1 GGA? [X] Yes [] No

NOTICE OF INTENT TO DRILL FEB 19 2004

Must be approved by KCC five (5) days prior to commencing well

Ap. 100's & 115' W KCC WICHITA

Expected Spud Date March 15, 2004 month day year of

Spot E/2 - SE - NW Sec. 28 Twp. 18 S. R. 17 [] East [X] West 3200 feet from [] N / [X] S Line of Section 3085 feet from [X] E / [] W Line of Section Is SECTION [X] Regular [] Irregular?

OPERATOR: License# 4419 Name: Bear Petroleum, Inc. Address: P.O. Box 438 City/State/Zip: Haysville, KS 67060 Contact Person: Dick Schremmer Phone: 316-524-1225

(Note: Locate well on the Section Plat on reverse side) County: Rush Lease Name: Holopirek Well #: 28-1 Field Name: Timken

CONTRACTOR: License# 5123 Name: Pickrell Drilling Co., Inc.

Is this a Prorated / Spaced Field? [] Yes [X] No

Well Drilled For: [X] Oil [] Gas [] OWWO [] Seismic; # of Holes [] Other Well Class: [X] Infield [X] Pool Ext. [] Wildcat [] Other Type Equipment: [X] Mud Rotary [] Air Rotary [] Cable

Target Formation(s): Arbuckle Nearest Lease or unit boundary: 660 Ground Surface Elevation: 1973 feet MSL

If OWWO: old well information as follows: Operator: Well Name: Original Completion Date: Original Total Depth:

Water well within one-quarter mile: [X] Yes [] No Public water supply well within one mile: [] Yes [X] No

Directional, Deviated or Horizontal wellbore? [] Yes [X] No

Depth to bottom of fresh water: 280 Depth to bottom of usable water: 540-460 Surface Pipe by Alternate: [X] 1 [] 2

If Yes, true vertical depth: Bottom Hole Location: KCC DKT #:

Length of Surface Pipe Planned to be set: 915 Length of Conductor Pipe required: N/A NONE Projected Total Depth: 3750 Formation at Total Depth: Arbuckle

Water Source for Drilling Operations: [X] Well [] Farm Pond Other DWR Permit #:

* WAS: 3300' FSL, 3300' FEL LOC IS: 3200' FSL, 3085' FEL

(Note: Apply for Permit with DWR []) Will Cores be taken? [] Yes [X] No If Yes, proposed zone:

AFFIDAVIT

SPOT WAS: SE NW SPOT IS: AP 100'S & 115' W OF E/2 SE NW

The undersigned hereby affirms that the drilling, completion and eventual plugging of this well will comply with K.S.A. 55 et. seq.

It is agreed that the following minimum requirements will be met:

- 1. Notify the appropriate district office prior to spudding of well; 2. A copy of the approved notice of intent to drill shall be posted on each drilling rig; 3. The minimum amount of surface pipe as specified below shall be set by circulating cement to the top; in all cases surface pipe shall be set through all unconsolidated materials plus a minimum of 20 feet into the underlying formation. 4. If the well is dry hole, an agreement between the operator and the district office on plug length and placement is necessary prior to plugging; 5. The appropriate district office will be notified before well is either plugged or production casing is cemented in; 6. If an ALTERNATE II COMPLETION, production pipe shall be cemented from below any usable water to surface within 120 days of spud date. Or pursuant to Appendix "B" - Eastern Kansas surface casing order #133,891-C, which applies to the KCC District 3 area, alternate II cementing must be completed within 30 days of the spud date or the well shall be plugged. In all cases, NOTIFY district office prior to any cementing.

I hereby certify that the statements made herein are true and to the best of my knowledge and belief.

Date: 2-18-04 Signature of Operator or Agent: [Signature] Title: President

For KCC Use ONLY API # 15 - 165-21756-00-00 Conductor pipe required NONE feet Minimum surface pipe required 480 feet per Alt (1) Approved by: RSP 2-20-04 / RSP 4-27-04 This authorization expires: 9-20-04 (This authorization void if drilling not started within 6 months of effective date.) Spud date: Agent:

Remember to:

- File Drill Pit Application (form CDP-1) with Intent to Drill; - File Completion Form ACO-1 within 120 days of spud date; - File acreage attribution plat according to field proration orders; - Notify appropriate district office 48 hours prior to workover or re-entry; - Submit plugging report (CP-4) after plugging is completed; - Obtain written approval before disposing or injecting salt water. - If this permit has expired (See: authorized expiration date) please check the box below and return to the address below.

[] Well Not Drilled - Permit Expired Signature of Operator or Agent: Date:

Mail to: KCC - Conservation Division, 130 S. Market - Room 2078, Wichita, Kansas 67202

28 18 17w

RECEIVED

FEB 19 2004

KCC WICHITA

IN ALL CASES PLOT THE INTENDED WELL ON THE PLAT BELOW

Plat of acreage attributable to a well in a prorated or spaced field

If the intended well is in a prorated or spaced field, please fully complete this side of the form. If the intended well is in a prorated or spaced field complete the plat below showing that the well will be properly located in relationship to other wells producing from the common source of supply. Please show all the wells and within 1 mile of the boundaries of the proposed acreage attribution unit for gas wells and within 1/2 mile of the boundaries of the proposed acreage attribution unit for oil wells.

API No. 15 - _____
Operator: Bear Petroleum, Inc.
Lease: Holopirek
Well Number: 28-1
Field: Timken

Location of Well: County: Rush
~~3300~~ 3200 feet from N / S Line of Section
~~3300~~ 3085 feet from E / W Line of Section
Sec. 28 Twp. 18 S. R. 17 East West



Number of Acres attributable to well: _____
QTR / QTR / QTR of acreage: E 1/2 SE NW
AP 100's 1/4 1/5 W of

Is Section: Regular or Irregular

If Section is Irregular, locate well from nearest corner boundary.
Section corner used: NE NW SE SW

PLAT

*(Show location of the well and shade attributable acreage for prorated or spaced wells.)
(Show footage to the nearest lease or unit boundary line.)*

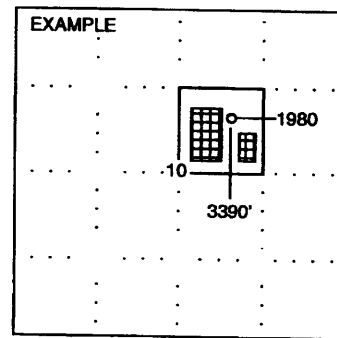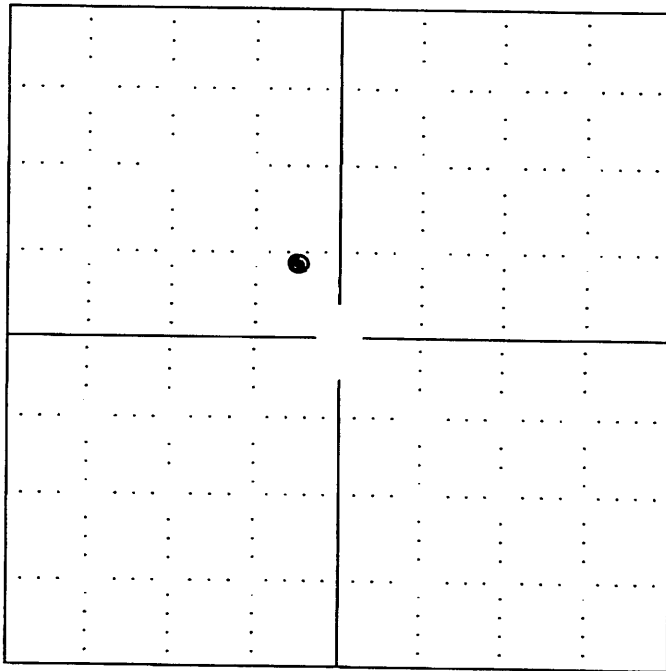

NOTE: In all cases locate the spot of the proposed drilling locaton.

In plotting the proposed location of the well, you must show:

1. The manner in which you are using the depicted plat by identifying section lines, i.e. 1 section, 1 section with 8 surrounding sections, 4 sections, etc.
2. The distance of the proposed drilling location from the section's south / north and east / west.
3. The distance to the nearest lease or unit boundary line.
4. If proposed location is located within a prorated or spaced field a certificate of acreage attribution plat must be attached: (CO-7 for oil wells; CG-8 for gas wells).