


STATE OF KANSAS
STATE CORPORATION COMMISSION

Give All Information Completely
Make Required Affidavit
Mail or Deliver Report to:
Conservation Division
State Corporation Commission
800 Bittling Building
Wichita, Kansas

15-147-19045-00-00

WELL PLUGGING RECORD

NORTH

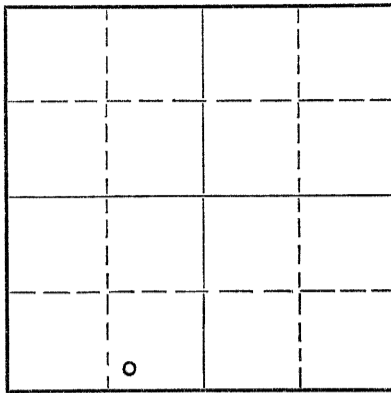

Locate well correctly on above Section Plat

Phillips

County. Sec. 29 Twp. 1S Rge. 18W (E) (W)

Location as "NE/CNW%SW%" or footage from lines SW SE SW

Lease Owner Lawrence Supply Company

Lease Name Goddard Well No. 1

Office Address Box 448 - Great Bend, Kansas

Character of Well (completed as Oil, Gas or Dry Hole) Oil

Date well completed August 1, 1950 19

Application for plugging filed December 11, 1953 19

Application for plugging approved December 14, 1953 19

Plugging commenced December 14 19 53

Plugging completed December 16 19 53

Reason for abandonment of well or producing formation

If a producing well is abandoned, date of last production 19

Was permission obtained from the Conservation Division or its agents before plugging was commenced? Yes

Name of Conservation Agent who supervised plugging of this well Eldon Petty

Producing formation Depth to top Bottom Total Depth of Well 3558 Feet

Show depth and thickness of all water, oil and gas formations.

OIL, GAS OR WATER RECORDS

CASING RECORD

FORMATION	CONTENT	FROM	TO	SIZE	PUT IN	PULLED OUT
				8-5/8"	225'	None
				5-1/2"	3554'	1266'

Describe in detail the manner in which the well was plugged, indicating where the mud fluid was placed and the method or methods used in introducing it into the hole. If cement or other plugs were used, state the character of same and depth placed, from feet to feet for each plug set.

Filled hole with sand from 3558' to 3470' and ran 4 sacks of cement. Checked fluid to 225'. Set a 10' rock bridge from 225' to 215' and ran 15 sacks of cement. Mudded the hole to 40', set a 10' rock bridge and ran 10 sacks of cement on top. Plugging compl.

(If additional description is necessary, use BACK of this sheet)

Name of Plugging Contractor West Supply Company

Address Chase, Kansas

STATE OF Kansas, COUNTY OF Barton, ss.

L. B. Lawrence (employee of owner) or (owner or operator) of the above-described well, being first duly sworn on oath, says: That I have knowledge of the facts, statements, and matters herein contained and the log of the above-described well as filed and that the same are true and correct. So help me God. Lawrence Supply Co.

(Signature) Lawrence

Box 448, Great Bend, Kansas (Address)

SUBSCRIBED AND SWORN TO before me this 28th day of January, 1954

My commission expires Sept. 15, 1956

Notary Public. Walter J. Volk

24-7368-S 3-53-20M

PLUGGING
FILE DEC 29 T 1 R 18W
BOOK PAGE 149 LINE 1

Jan 30, 1954

POWELL & PETERS DRILLING CO., INC.
Great Bend, Kansas

Ira Goddard No. 1
(Federal Farm No. 1)

SW SE SW 29-18-18W
Phillips County, Kansas

Commenced R. D.: 7/23/50
Completed R. D.: 8/1/50
Total Depth: 3558'

Initial Prdd:
Elevation: 2254'
Contractor: Honaker Drilling
Co., Inc.

Casing: 225' of 8 5/8" 8rd thd.
3554.63' of 5 1/2" OD

15-147-19045-00-00

Strata	Depth
Soil and Sand	0 - 70'
Shale	70 - 140
Sand	140 - 250
Shale	250 - 600
Sand and Shale	600 - 725
Shale and Shells	725 - 775
Sand and Shale	775 - 900
Shale and Shells	900 - 1120
Sand	1120 - 1150
Shale and Shells	1150 - 1300
Sand	1300 - 1400
Shale and Red Bed	1400 - 1750
Red Bed	1750 - 1820
Shale and Anhydrite	1820 - 1860
Shale and Red Bed	1860 - 1920
Shale and Shells	1920 - 2050
Shale and Lime	2050 - 3240
Lime	3240 - 3535
Shale and Lime	3535 - 3558

I hereby certify that the above is a true and correct log of said well as reflected by the daily drilling reports.

POWELL & PETERS DRILLING CO., INC.

by

A. R. Peters


A. R. Peters

Vice - Pres.

Signed and sworn to in my presence this 12th day of October, 1950, by A. R. Peters, Vice-President of the POWELL & PETERS DRILLING CO., INC., a corporation in the State of Kansas.

Notary Public

My Commission expires: _____

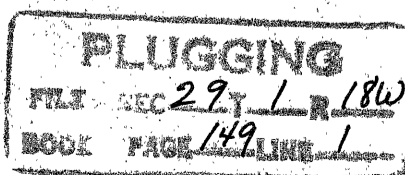

W