


STATE OF KANSAS
STATE CORPORATION COMMISSION

Give All Information Completely
Make Required Affidavit
Mail or Deliver Report to:
Conservation Division
State Corporation Commission
800 Bitting Building
Wichita, Kansas

15-147-00103-00-00

WELL PLUGGING RECORD

NORTH

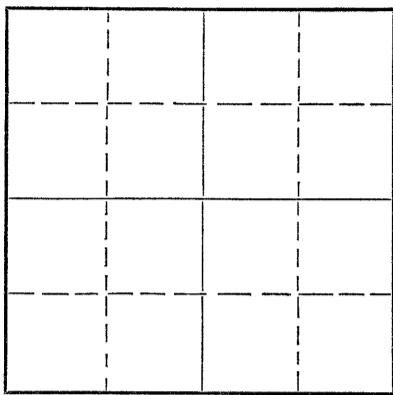

Locate well correctly on above
Section Plat

Phillips County. Sec. 33 Twp. 1-S Rge. 18 (E) (W)
Location as "NE/CNW $\frac{1}{4}$ SW $\frac{1}{4}$ " or footage from lines Cn W/2 ~~W~~ NE
Lease Owner Smitherman & Cohen SW
Lease Name Ann Lowe "A" Well No. 1
Office Address 105 $\frac{1}{2}$ N. Main, El Dorado, Kansas
Character of Well (completed as Oil, Gas or Dry Hole) _____
Date well completed July 25 19 52
Application for plugging filed July 25 19 52
Application for plugging approved July 25 19 52
Plugging commenced July 29 19 52
Plugging completed _____ 19 _____
Reason for abandonment of well or producing formation _____

If a producing well is abandoned, date of last production _____ 19 _____
Was permission obtained from the Conservation Division or its agents before plugging was commenced? Yes

Name of Conservation Agent who supervised plugging of this well Eldon Petty
Producing formation _____ Depth to top _____ Bottom _____ Total Depth of Well 3575 Feet
Show depth and thickness of all water, oil and gas formations.

OIL, GAS OR WATER RECORDS

CASING RECORD

Formation	Content	From	To	Size	Put In	Pulled Out
				5-1/2"	3561'	1489'
				8-5/8"	243'	None

Describe in detail the manner in which the well was plugged, indicating where the mud fluid was placed and the method or methods used in introducing it into the hole. If cement or other plugs were used, state the character of same and depth placed, from _____ feet to _____ feet for each plug set.

Sanded hole from 3571' to 3550' and ran 4 sacks of cement. Bailed hole. Mudded hole to 234', set rock bridge to 220' and ran 15 sacks of cement. Mudded hole to 35', set rock bridge and ran 10 sacks of cement. Plugging completed.

AUG 15 1952
CONSERVATION DIVISION
Wichita, Kansas

Aug 15, 1952

(If additional description is necessary, use BACK of this sheet)

Name of Plugging Contractor West Supply Company
Address Chase, Kansas

STATE OF Kansas, COUNTY OF Butler, SS.
L. C. Smitherman (employee of owner) or (owner or operator) of the above-described well,
being first duly sworn on oath, says: That I have knowledge of the facts, statements, and matters herein contained and the log of the above-described well as filed and that the same are true and correct. So help me God.

(Signature) *L. C. Smitherman*

(Address) _____

SUBSCRIBED AND SWORN to before me this 13th day of August, 1952.

My commission expires March 3, 1955

Notary Public.

23-8390-s 6-51-20M

PLUGGING
FILE SEC 33 T 1 R 18
BOOK PAGE 39 LINE 7