


Give All Information Completely  
Make Required Affidavit  
Mail or Deliver Report to:  
Conservation Division  
State Corporation Commission  
800 Bittling Building  
Wichita, Kansas

15-147-19050-00-00  
WELL PLUGGING RECORD

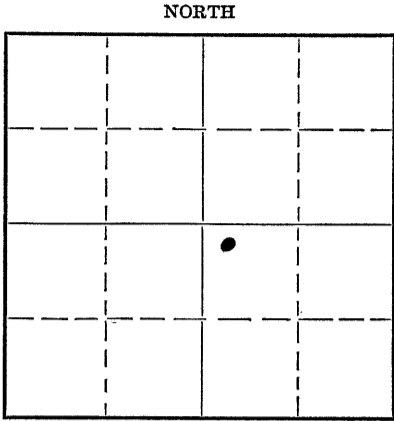

Locate well correctly on above  
Section Plat

Phillips County. Sec. 33 Twp. 1 Rge. 18 (E) W (W)  
Location as "NE/CNW $\frac{1}{4}$ SW $\frac{1}{4}$ " or footage from lines NW NW SE  
Lease Owner Honaker Drilling Co., Inc., et al  
Lease Name Ann Lowe Well No. 2A  
Office Address Great Bend, Kansas  
Character of Well (completed as Oil, Gas or Dry Hole) Pipe stuck, skidded rig  
Date well completed 3-5 1951  
Application for plugging filed 3-5 1951  
Application for plugging approved 3-5 1951  
Plugging commenced 3-5 1951  
Plugging completed 3-5 1951  
Reason for abandonment of well or producing formation 7" OD oil string stuck at 2663', pulled in two. Left 823' pipe in hole.  
If a producing well is abandoned, date of last production No 19  
Was permission obtained from the Conservation Division or its agents before plugging was commenced? Yes

Name of Conservation Agent who supervised plugging of this well Eldon Petty  
Producing formation Depth to top Bottom Total Depth of Well 3570 Feet  
Show depth and thickness of all water, oil and gas formations.

OIL, GAS OR WATER RECORDS

CASING RECORD

Formation	Content	From	To	Size	Put In	Pulled Out

Describe in detail the manner in which the well was plugged, indicating where the mud fluid was placed and the method or methods used in introducing it into the hole. If cement or other plugs were used, state the character of same and depth placed, from feet to feet for each plug set.  
Filled hole with heavy mud, set plug at 190', cemented with 15 sacks cement. Filled hole to 40' with heavy mud, set plug with 20 sacks cement.

(If additional description is necessary, use BACK of this sheet)  
Correspondence regarding this well should be addressed to Honaker Drilling Co., Inc.  
Address Great Bend, Kansas

STATE OF Kansas, COUNTY OF Barton, ss.  
Don Cromer (employee of owner) or (owner or operator) of the above-described well,  
being first duly sworn on oath, says: That I have knowledge of the facts, statements, and matters herein contained and the log of the above-described well as filed and that the same are true and correct. So help me God.

(Signature) Don Cromer  
Great Bend, Kansas (Address)

SUBSCRIBED AND SWORN to before me this 13th day of March, 1951  
L. E. Caraway Notary Public.

My commission expires 9-1-54 23-5091-s 8-50-10M

PLUGGING  
FILE SEC 33 T 1 R 18W  
PAGE 66 LINE 7

MAR 14 1951  
CONSERVATION DIVISION  
Wichita, Kansas

DRILLERS LOG

Contractor: Honaker Drilling Co., Inc.

Operator: Honaker Drilling Co., Inc.

Lease: Ann Lowe #2 A

15-147-19050-00-00

	<u>From</u>	<u>To</u>
Surface Soil & Lime	0	135
Sand	135	170
Shale & Shells	170	206

Run 215' used surface casing, set at 206', cemented with 125 sacks and 500# C.C.

Shale & Shells	206	1256
Anhydrite	1256	1275
Shale & Shells	1275	1725
Red Bed & Shale	1725	1825
Anhydrite	1825	1840
Shale & Shells	1840	2215
Shale & Lime	2215	2491
Shale & Shells	2491	2620
Shale & Lime	2620	3100
Line	3100	3145
Shale & Lime	3145	3214
Line	3214	3366
Line & Shale	3366	3420
Line	3420	3570 T. D.

Run 2666.12' 7" casing, and stuck same. Skidded Rig 50', and started new hole.

The foregoing statement is correct to the best of my knowledge.

HONAKER DRILLING CO., INC.

By \_\_\_\_\_

RECEIVED  
STATE CORPORATION COMMISSION  
MAR 14 1951  
CONSERVATION DIVISION  
Wichita, Kansas

PLUGGING  
FILE SEC 33 T-1 R 18 W  
BOOK PAGE 66 LINE 7

COPY