


STATE OF KANSAS
STATE CORPORATION COMMISSION

Give All Information Completely
Make Required Affidavit
Mail or Deliver Report to:
Conservation Division
State Corporation Commission
800 Biting Building
Wichita, Kansas

13-147-00051-00-00
WELL PLUGGING RECORD

NORTH

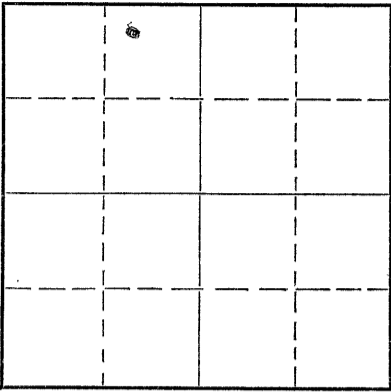

Locate well correctly on above
Section Plat

Phillips County. Sec. 20 Twp. 1 Rge. 19 (E) (W)
Location as "NE/CNW $\frac{1}{4}$ SW $\frac{1}{4}$ " or footage from lines NW NE NW
Lease Owner A. R. Peters, Et. al.
Lease Name Skelton Well No. 1
Office Address Great Bend, Kansas
Character of Well (completed as Oil, Gas or Dry Hole) Dry Hole
Date well completed June 14, 1950 19
Application for plugging filed June 15, 1950 19
Application for plugging approved 19
Plugging commenced June 15, 1950 19
Plugging completed June 15, 1950 19
Reason for abandonment of well or producing formation Dry Hole
If a producing well is abandoned, date of last production 19
Was permission obtained from the Conservation Division or its agents before plugging was commenced? Yes

Name of Conservation Agent who supervised plugging of this well Eldon Petty
Producing formation Depth to top Bottom Total Depth of Well 3615' Feet
Show depth and thickness of all water, oil and gas formations.

OIL, GAS OR WATER RECORDS

CASING RECORD

Formation	Content	From	To	Size	Put In	Pulled Out
Surface	Casing			8 5/8"	209'	None

Describe in detail the manner in which the well was plugged, indicating where the mud fluid was placed and the method or methods used in introducing it into the hole. If cement or other plugs were used, state the character of same and depth placed, from feet to feet for each plug set.

Placed Plug at 200' and Cemented with 15 Sacks of Cement
Placed plug at 15' and Cemented to Ground Level.

RECEIVED
08-04-50
AUG 4 1950
STATE CORPORATION COMMISSION
KANSAS

(If additional description is necessary, use BACK of this sheet)


Correspondence regarding this well should be addressed to A. R. Peters, et. al., American State Bank Bldg.,
Address Great Bend, Kansas

STATE OF Kansas, COUNTY OF Barton, ss.
A. R. Peters (employee of owner) or (owner or operator) of the above-described well,
being first duly sworn on oath, says: That I have knowledge of the facts, statements, and matters herein contained and the log of the above-described well as filed and that the same are true and correct. So help me God.
(Signature) *A R Peters*
Great Bend, Kansas (Address)

SUBSCRIBED AND SWORN to before me this 3 day of August, 19 50

Detter Miner
Notary Public.

My commission expires September 29, 1951

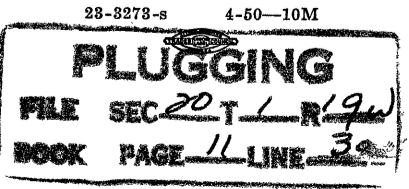

DRILLER'S LOG

Operator A. R. Peters et al

Contractor Honaker Drilling Co., Inc.

Lease Skelton #1

15-147-00051-00-00

	<u>From</u>	<u>To</u>
Sand & Soil	0	95
Shale & Sand	95	205

C Run 209' 8-5/8" casing, cemented with 125 sacks cement, 100# CaCl.

Shale	205	612
Lime	612	650
Shale	650	900
Shale & Sand	900	1100
Shale & Shells	1100	1300
Sand & Shale	1300	1540
Shale	1540	1890

	<u>From</u>	<u>To</u>
Red Bed	1890	1930
Shale & Shells	1930	2020
Lime & Shale	2020	2215
Shale	2215	2360
Shale & Lime	2360	2415
Lime	2415	2540
Lime & Shale	2540	2560
Shale & Pyrite	2560	2635
Shale & Lime	2635	3275
Lime	3275	3325
Lime & Shale	3325	3365
Lime	3365	3615

T. D. 3615'

Company Time W. D. P.

P			
6-12-50	Circulating	2 Hrs.	30 Min.
6-13-50	Circulating	1 Hr.	45 Min.
6-14-50	Circulating	8 Hrs.	

(Above depths are Rotary Bushing Measurements, less 4' to ground level)

Y

The foregoing is correct to the best of my knowledge.

HONAKER DRILLING CO., INC.

By J. J. Honaker
resident

PLUGGING
FILE SEC 20 T 1 R 194
BOOK PAGE 11 LINE 35