

15-147-00420-00-00


STATE OF KANSAS
STATE CORPORATION COMMISSION

Form CP-4

WELL PLUGGING RECORD

Give All Information Completely
Make Required Affidavit
Mail or Deliver Report to:
Conservation Division
State Corporation Commission
212 No. Market
Wichita, Kansas

NORTH

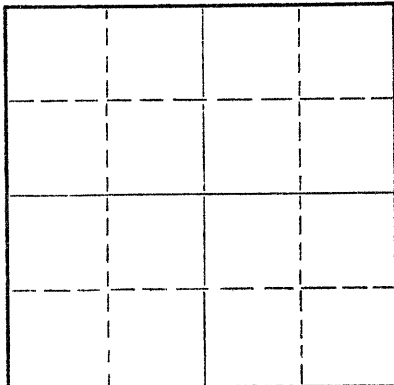

Locate well correctly on above
Section Plat

Phillips County, Sec. 30 Twp. 1 Rge. 18 (E) (W) X

Location as "NE/CNW'SW" or footage from lines C NW NE

Lease Owner Sierra Petroleum Co.

Lease Name Schluntz Well No. #5

Office Address Box 232, Russell, Kansas

Character of Well (completed as Oil, Gas or Dry Hole)

Date well completed 19

Application for plugging filed 8-19-66 19

Application for plugging approved 19

Plugging commenced 9-9-66 19

Plugging completed 9-14-66 19

Reason for abandonment of well or producing formation

If a producing well is abandoned, date of last production 19

Was permission obtained from the Conservation Division or its agents before plugging was commenced?

Name of Conservation Agent who supervised plugging of this well Leo Massey

Producing formation Depth to top Bottom Total Depth of Well 3665' Feet

Show depth and thickness of all water, oil and gas formations.

OIL, GAS OR WATER RECORDS

CASING RECORD

FORMATION	CONTENT	FROM	TO	SIZE	PUT IN	PULLED OUT

Describe in detail the manner in which the well was plugged, indicating where the mud fluid was placed and the method or methods used in introducing it into the hole. If cement or other plugs were used, state the character of same and depth placed, from feet to feet for each plug set.

Made bottom hole plug back with sand to 3400', mixed and ran 3 sacks cement thru dump bailer.

Squeezed hole with 20 sacks gel and 75 sacks cement

RECEIVED
STATE CORPORATION COMMISSION

SEP 19 1966

CONSERVATION DIVISION
Wichita, Kansas

(If additional description is necessary, use BACK of this sheet)

Name of Plugging Contractor Southwest Casing Pulling Co., Inc.

Address Box 364, Great Bend, Kansas

STATE OF Kansas, COUNTY OF Barton, ss.

Southwest Casing Pulling Co., Inc. (employee of owner) or (owner or operator) of the above-described well, being first duly sworn on oath, says: That I have knowledge of the facts, statements, and matters herein contained and the log of the above-described well as filed and that the same are true and correct. So help me God.

(Signature) W. C. Spencer Sec.

Box 364, Great Bend, Kansas (Address)

SUBSCRIBED AND SWORN TO before me this 16 day of September, 19 66

Sidney D. Miller

Notary Public.

My commission expires 24 October 1968

15-147-00420-00-00


WELL LOG BUREAU—KANSAS GEOLOGICAL SOCIETY
508 East Murdock, Wichita, Kansas

Company: FELDT-LAYTAG & COMPANY
Farm: Schluntz No. 5

SEC. 30 1 R. 10W
C. NW NE

Total Depth: 3665'
Comm. 2-8-60 Comp. 2-16-60
Shot or Treated.
Contractor: Lehen Drilling, Inc.
Issued: 6-4-60

County Phillips
KANSAS

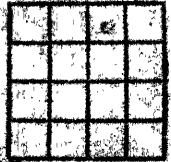

CASING:
8 5/8" 234' cem. w/150 sx.
4" 3665'

Elevation: 2231 RB

Production: 25 BOPD

Figures indicate Bottom of Formations.

shale & sand	224
shale	1425
sand	1535
shale	1650
shale & red bed	1821
anhydrite	1847
shale	2465
lime	2530
lime & shale	3035
shale	3170
lime & shale	3550
lime	3665 RTD
Total Depth	
TOPS: SCOUT	
Heebner	3381
Toronto	3407
Lanning	3423
Base Kansas City	3632

RECEIVED
STATE CORPORATION COMMISSION
SEP 20 1966
CONSERVATION DIVISION
Wichita, Kansas

3381	3407	3423	3665
2231	2231	2231	2231
-1150	-1176	-1176	-1434

Handwritten notes and calculations at the bottom of the page, including various numbers and possibly well identifiers.