


WELL PLUGGING RECORD

Give All Information Completely
Make Required Affidavit
Mail or Deliver Report to:
Conservation Division
State Corporation Commission
212 No. Market
Wichita, Kansas

NORTH

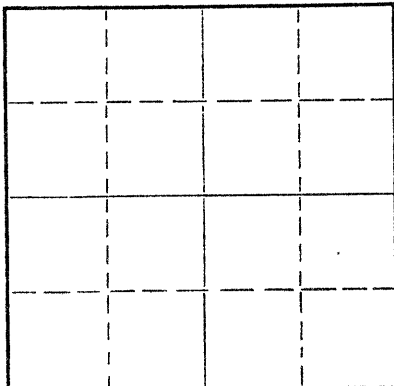

Locate well correctly on above
Section Plat

Phillips County. Sec. 30 Twp. 1 Rge. 18 (E) (W) x
Location as "NE/CNW%SW%" or footage from lines SE SW NE
Lease Owner Sierra Petroleum Co.
Lease Name Schluntz Well No. #2
Office Address Box 232, Russell, Kansas
Character of Well (completed as Oil, Gas or Dry Hole)
Date well completed 19
Application for plugging filed 8-18-66 19
Application for plugging approved 19
Plugging commenced 9-8-66 19
Plugging completed 9-14-66 19
Reason for abandonment of well or producing formation

If a producing well is abandoned, date of last production 19
Was permission obtained from the Conservation Division or its agents before plugging was commenced?

Name of Conservation Agent who supervised plugging of this well Leo Massey
Producing formation Depth to top Bottom Total Depth of Well 3650 Feet
Show depth and thickness of all water, oil and gas formations.

OIL, GAS OR WATER RECORDS

CASING RECORD

FORMATION	CONTENT	FROM	TO	SIZE	PUT IN	PULLED OUT

Describe in detail the manner in which the well was plugged, indicating where the mud fluid was placed and the method or methods used in introducing it into the hole. If cement or other plugs were used, state the character of same and depth placed, from feet to feet for each plug set.

Made bottom hole plug back with sand to 3400', mixed and ran 3 sacks cement thru dump bailer.
Squeezed well with 20 sacks gel and 75 sacks cement.

Received
Aug. 19, 1966
Sept.

(If additional description is necessary, use BACK of this sheet)

Name of Plugging Contractor Southwest Casing Pulling Co., Inc.
Address Box 364, Great Bend, Kansas

STATE OF Kansas, COUNTY OF Barton, ss.
Southwest Casing Pulling Co., Inc. (employee of owner) or (owner or operator) of the above-described well, being first duly sworn on oath, says: That I have knowledge of the facts, statements, and matters herein contained and the log of the above-described well as filed and that the same are true and correct. So help me God.

(Signature) W. C. Spencer Sec.
Box 364, Great Bend, Kansas
(Address)

SUBSCRIBED AND SWORN TO before me this 16 day of September, 1966

Sidney D. Miller
Notary Public.

My commission expires 24 October 1968

WELL LOG BUREAU--KANSAS GEOLOGICAL SOCIETY
502 East Murdock, Wichita, Kansas

Company- FELDT-MAYTAG & COMPANY
Farm- Schluntz No. 2

SEC. 30 T. 1 R. 18W
SE SW NE

15-147-00417-00-00

Total Depth. 3650'
Comm. 3-4-59 Comp. 3-15-59
Shot or Treated.
Contractor. Lewis Drlg. Co.
Issued. 5-30-59

County Phillips
KANSAS



Elevation. 2170' KB

Production. 25 BOPD

CASING:

3 5/8" @ 212'
4 1/2" @ 3650'

Figures Indicate Bottom of Formations.

sand & post rock	140
clay	212
shale	1370
shale & sand	1500
shale & shells	1700
anhydrite	1820
shale & lime	2110
shale	2310
lime	2545
lime & shale	3245
lime	3365
lime & shale	3465
lime	3490
lime & shale	3650
Total Depth	

TOPS:	
Heebner	3363
Toronto	3394
Lansing	3406
Base/Kansas City	3520

RECEIVED
STATE CORPORATION COMMISSION

SEP 20 1966

CONSERVATION DIVISION
Wichita, Kansas